


**CERTIFIED RECORD OF LAND CORNER MONUMENTATION**

History of original corner establishment: Originally established by William M. Gibb, G.L.O. Deputy Surveyor, in 1910:

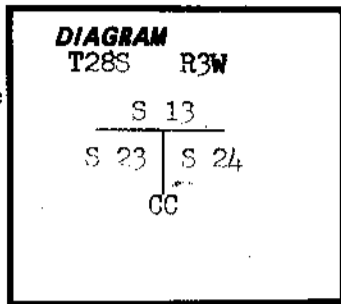

- a 6x6x16 ins. stone, 11 ins. in the ground, marked CC on S. face with 1 groove on E. and 5 grooves on W. face; from which
  - A fir, 14 ins. diam., bears S27\*E, 13 lks. dist., marked T 28 S R 3 W S 24 B T.
  - A fir, 18 ins. diam., bears S52\*W, 62 lks. dist., marked T 28 S R 3 W S 23 B T.

Perpetuated by Thomas Shrum Jr., Registered Engineer 4287, in 1960 (County renewal # 16):


- found- 6"x6"x11" stone; 18" fir S.27\*E. 8.6 ft. (down); 22" fir S.52\*W. 42.5 ft.(stump)
- set- 3/4"x36" Iron Rod; 5" Yew S.01\*30'W. 33.6 ft.; 15 Fir N.85\*E. 64.5 ft.; 15" Fir S.24\*30'E. 58.8 ft.

And further perpetuated by Victor M. McLind, L. S. 934, in 1978 (M70-36):

- found 1" iron rod with aluminum cap, from which:
  - 22" fir stump bears S52W, 42.5 ft., face not visible; 6" Yew bears S4W, 33.4 ft., face w/ scribing visible; 15" Fir bears N85E, 64.2 ft., face w/ scribing visible; 15" Fir bears S24\*30'E, 58.5 ft., face w/ scribing.

March 17, 1988: I find a 1" iron rod, firmly set, projecting 30" above a 2 ft. diam. mound of stone with a 2 1/4" aluminum cap marked as shown: from which the remains of the original B. T.:

- A 24" Douglas fir stump, S52\*W, 42.2(rec. 40.92)ft., with a healed blaze. and B. T.s marked by Shrum in 1960:
- A 16" Douglas fir, N85\*E, 64.5 ft., with scribe marks "S13 RE4287 CC" visible on a partially healed double blaze.
- A roothole, S24\*E, 58.8 ft., with a downed 15" Douglas fir alongside with a partially healed double blaze.
- A 6" Yewwood, S01\*W, 33.1 ft.(rec. 33.6 ft.), with scribe marks "S23 RE4287 CC" visible on a partially healed double blaze.

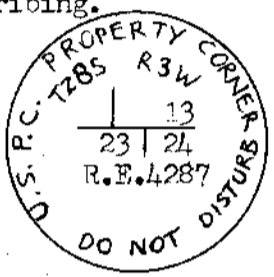

**Description of monument and accessories established to perpetuate the original location of this corner:**

March 17, 1988: I add a 3 ft. diameter mound of stone to the found monument, which now projects 20" .

- From which:
- at the true closing corner point per M70-36, I set a 6 ft. steel fence post, driven 2 ft. in the ground as a guard post, S01\*E, 2.1 ft., with Forest Service signs #54-2 and 54-4 attached.
  - and a B. T. I mark:
    - A 5" hemlock, S 30\*E, 26.5 ft., scribed "T28S R3W S24 CC BT" on a single blaze with a 3/4" diameter brass washer, stamped "LS1181", nailed flush to the base of the blaze.

I found the magnetic declination to be 20\* East.

Party chief: Leonard Herzstein  
Witness: Peggy Roberts

To reach the corner: 2.2 mi. past the end of the pavement on Cavitt Creek Road No. 25, turn West onto road # 28-3-15 (Champion road # CC900). Drive 1.9 mi. and turn left onto road # 28-3-11 (CC920). Drive 2.8 mi. and turn left onto Forest Road No. 1800-127. Drive 0.2 mi. to the section line crossing. The corner is approximately 150 ft. West of the road at the culvert.

**FILED**  
*ll*  
**MAR 30 1988**  
**COUNTY SURVEYOR**  
**DOUGLAS COUNTY, ORE.**

Office of.....Surveyor..... County of...Douglas.....  
State of...Oregon....., I hereby certify that the within instrument was filed in this office for record on the 30 day of March 19 88  
.....Fritz Ingram..... by *Virginia C. Laugen* (DEPUTY)  
(COUNTY OFFICIAL)

**REGISTERED PROFESSIONAL LAND SURVEYOR**

*Maurice E Farr*  
**OREGON**  
SEPT. 23, 1977  
**MAURICE E. FARR**  
1181

Form R6-7100-57 (9/71)

#162 H

C.S. FILE NO. 63/73-2 3-21-88