

GOVERNMENT CORNER RESTORATION FORM

FILED

[Signature]

Township 26 S Range 1 W Sec. 1 County DOUGLAS
State OREGON Date 12 MAY 88 No. _____

MAY 23 1988
COUNTY SURVEYOR
DOUGLAS COUNTY, ORE

Corner Designation

CLOSING CORNER OF SECTIONS 1 AND 2, T26S, R1W, WM.

S2 | S1
C | C

- Condition Report of
- Not Found
- Renewed
- Unrecorded
- Surveyed In
- Referenced Out


Previous Renewals

Monument(s) Found: (Condition and Source)

18" X 9" X 5" WATER-WORN STONE LAYING ON THE GROUND WITH MARKS: "X" ON EAST SIDE (TOP OF STONE); "CC" ON NORTH SIDE; 1 GROOVE ON TOP; AND 5 GROOVES ON BOTTOM.

I WAS UNABLE TO LOCATE THE HOLE THE STONE CAME OUT OF. I USE THE CENTER OF THE STONE AS THE POSITION FOR THE CORNER POINT.

MONUMENT DETAIL

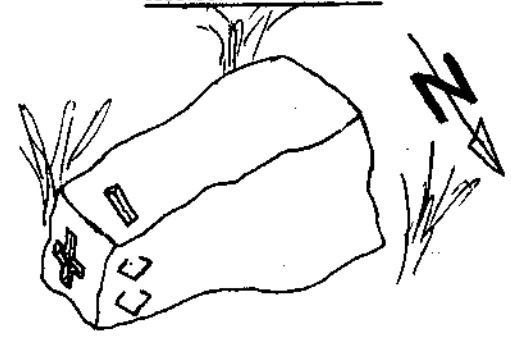

Accessories Found:

FROM WHICH THE REMAINS OF ORIGINAL BEARING TREES:

A 20" MADRONE STUMP, BEARS S 12° E, 27 1/2 FT. (REC. S 21° E, 42 LKS.), WITH NO MARKS VISIBLE ON PARTIALLY HEALED, DECAYED BLAZE.

A 30" DOUGLAS FIR STUMP S 40° W, 20 1/2 FT. (REC. S 44° W, 31 LKS) WITH HEALED BLAZE. I CHOP OPEN AND FIND SCRIBE MARKS "W" AT 8" DIAMETER.

#115 T.26-1 W
#163 T.25-1 W

C.S. File No. 63/73-3

