


CERTIFIED RECORD OF LAND CORNER MONUMENTATION

History of original corner establishment:


Corner established by George Grubb, L.S. 397, in 1981 on M87-65 and perpetuated by M. E. Farr, L.S. 1181, in 1988 in C.S. File No. 62/44.

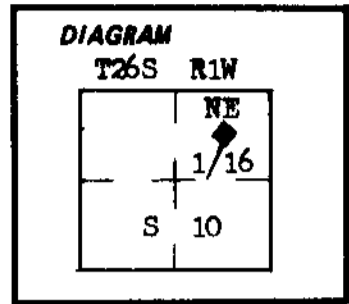

Description of corner evidence found:

Sept. 23, 1988, I find a 2-1/2" brass cap buried 6" under the ground and marked as shown (per 1981):
from which the bearing trees marked in 1988:

- A 10" Douglas Fir stump, N54°W, 23.9 ft. (rec. 23.7 ft.), with scribe mark "T" visible on a partially healed blaze.
- A 9" White Fir, NO 1/2°W, 26.9 ft. (rec. 26.5 ft.), with scribe marks "S10 BT" and a 3/4" brass washer stamped; LS 1181, visible on a partially healed single blaze.

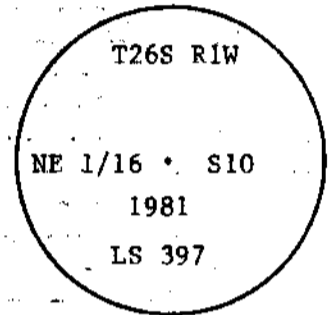

Description of monument and accessories I established to perpetuate the original location of this corner:

Sept. 23, 1988, I find a bearing object marked in 1981 in a new location. The B. O. is now:

- A 2"x2" "x" at the top S W corner of the campground sign post foundation bears S83°W, 163.1 ft.
- The other B. O. is now gone.

The corner is 2.0 ft. North of the north edge of the pavement of Highway 138 and 150 ft. East of the new entrance to Bogus Creek Campground.

I use a magnetic declination of 18 1/4° East.

Party Chief: Leonard Herzstein

REGISTERED
PROFESSIONAL
LAND SURVEYOR

Maurice E. Farr

OREGON
SEPT. 23, 1987
MAURICE E. FARR
1181

10-20-88

Office of..... Surveyor..... County of... Douglas.....
State of... Oregon....., I hereby certify that the within instrument was filed in this office
for record on the... 1st day of... November....., 19 88
Francis L. Ingram..... by *Therese A. Saenger*.....
(COUNTY OFFICIAL) (DEPUTY)