


FILED

*JL*  
DEC 30 1988

COUNTY SURVEYOR  
DOUGLAS COUNTY, ORE.

**COUNTY SURVEYORS FILE DATA  
DO NOT REMOVE FROM OFFICE**

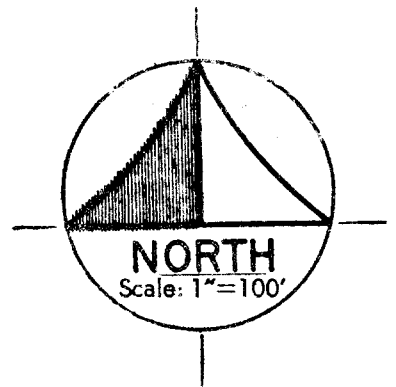

Narrative: The purpose of this survey was to establish a portion of the Easterly line of Government Lot 7 in Section 33, Township 21 South, Range 11 West. This survey is based on monuments found from the subdivision of Section 33 in Survey File No. M96-64. A closed traverse was established and sideshots to the corners indicated found were double tied using a Jena 20 second theodolite and IRA EDM.

- o indicates 5/8" x 24" iron rod set with yellow plastic cap marked "WOBBE - PLS 1093".
- ( ) indicates record data. There is no record data for distances not indicated otherwise.

JOB NO. F88-70

**WOBBE & ASSOCIATES, INC.**

510 Kingwood Street P.O. Box 1136  
Florence, OR 97439

SURVEY FOR:

HOWARD HINSDALE

SE 1/4, SEC. 33, T 21 S, R 11 W, W. M.  
DOUGLAS COUNTY, OREGON

DECEMBER 21, 1988

REGISTERED  
PROFESSIONAL  
LAND SURVEYOR

*Eugene M. Wobbe*

OREGON  
JULY 30, 1976  
EUGENE M. WOBBE  
1093

C.S. File No. 63/84