

FILED

JAN 6 1989

OREGON CORNER RESTORATION FORM


Section 34 Township 20S Range 9W

County Douglas Date 10-31-88

COUNTY SURVEYOR
DOUGLAS COUNTY, ORE.

CORNER DESIGNATION

West $\frac{1}{4}$ Corner
Section 34

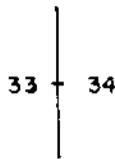

- Condition Report Only
- Not Found
- Renewed
- Unrecorded
- Surveyed In
- Referenced Out


Previous Renewals/Surveys, etc. A Thomas A. Tillman and Joseph S. Gawron G.L.O. Survey dated 1953-1954. A Survey by Roberts Surveying Inc. dated March 15, 1984.

Monument(s) & Accessories Found: (Condition and Source)

Found 1953 G.L.O. Brass Cap set firmly in the ground.
53" Cedar, N81W, 67.9' (No Marks), 1877 BT. Rec. N80 $\frac{1}{2}$ W, 66.0'
10" Hemlock Stub, N75E, 15.5' (Scribe Vis.), 1953 BT.
Record N77 $\frac{1}{2}$ E, 15.2'
19" Maple, N74W, 14.1' (Scar Vis.), 1953 BT. Rec. N75 $\frac{3}{4}$ W, 14.5'
N.E. Cedar BT set by Theil in 1877 and found in 1953 is gone.

Monument Detail

Sketch

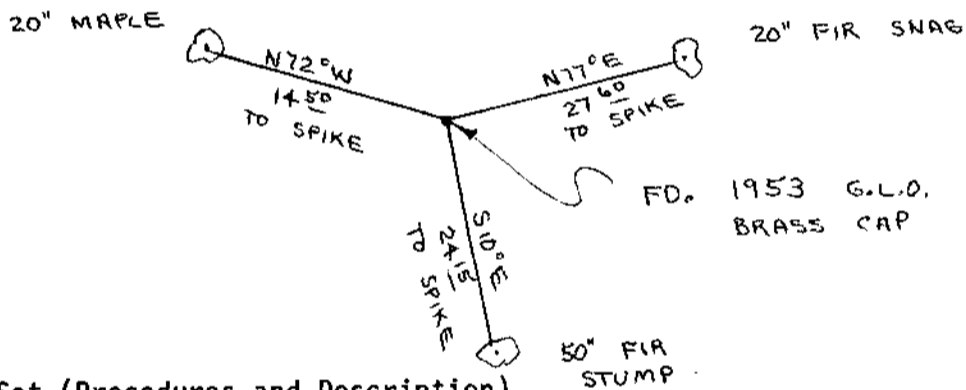

Monument Set (Procedures and Description)

New Accessories

Because of planned logging activity in this area in the near future, I set the following R.P.'s.
50" Fir Stump, S10E, 24.15' to 6" steel spike.
20" Fir Snag, N77E, 27.60' to 6" steel spike.
20" Maple, N72W, 14.50' to 6" steel spike.

Location & Comments

Corner lies on west slope in NW corner of old unit. Logging unit is about 15 years old.
Compass Declination 20 $\frac{1}{2}$
Firm/Agency Roberts Surveying Inc.
Address 29 west 29th St. Eugene, Oregon 97405
Party Chief Les Roberts
Notes Ted Baker
Witness _____

Surveyor's Seal



#66