

M167-26

FILED

JS

JAN 9 1989

OREGON CORNER RESTORATION FORM

Section 34 Township 21S Range 5W

County Douglas Date May 13, 1988

COUNTY SURVEYOR
DOUGLAS COUNTY, ORE.

Corner Designation

South East Corner

- Condition Report Only
- Not Found
- Renewed
- Unrecorded
- Surveyed In
- Referenced Out

Previous Renewals/Surveys, etc.

#18, #110


Monument(s) & Accessories Found: (Condition and Source)

32" Fir	N 21W	9.0 feet	Closed face	McGillicuddy	1953
28" White Fir	N 21E	31.3 feet	Closed Face	McGillicuddy	1953
48" Fir Stump	S 22W	44.2 Feet	Closed face evident	McGillicuddy	1953
30" Fir Stub	S 33E	17.2 Feet	scribing visible being original	1855 BT	

Monument Detail

Sketch

1965 Douglas County Brass Cap

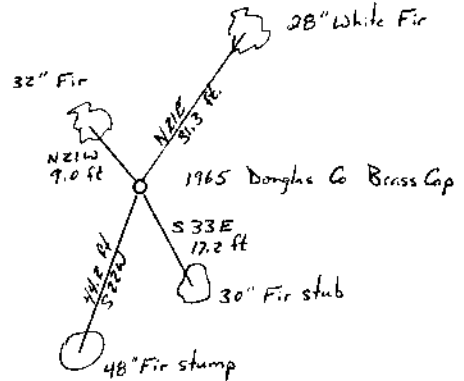

Monument Set (Procedures and Description)

None

New Accessories

None

Location & Comments

Surveyor's Seal

Compass Declination 20° E

Firm/Agency

Weyerhaeuser Company

Address P. O. Box 275

Springfield, Oregon 97477

Party Chief Dave Wellman

Notes

Witness Keith Comstock

REGISTERED
PROFESSIONAL
LAND SURVEYOR

David H. Wellman

OREGON
JULY 1985
DAVID H. WELLMAN
2163