

FILED

JL

JAN 9 1989

OREGON CORNER RESTORATION FORM

Section 3 Township 22 S Range 5 W

County Douglas Date 10-30-88

COUNTY SURVEYOR
DOUGLAS COUNTY, ORE.

Corner Designation

Property Corner

- Condition Report Only
- Not Found
- Renewed
- Unrecorded
- Surveyed In
- Referenced Out

Previous Renewals/Surveys, etc. _____


Monument(s) & Accessories Found: (Condition and Source)

Monument Detail

Sketch



yellow plastic cap
1" x 36" Iron pipe

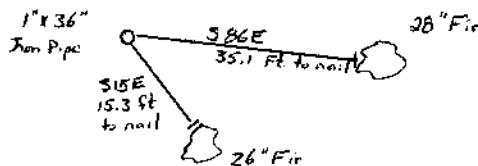

Monument Set (Procedures and Description)

1" x 36" iron pipe with yellow plastic cap inscribed 'Weyer Co'

Corner was set at the intersection of the North line of Section 3 and the deed call bearing (established by solar observation) of a line from a one-inch aluminum pipe on the west line of Section 3 as per deed record between Weyerhaeuser Company and Ben A. Johnson recorded in Volume 300, Page 333, of Douglas County Deed Records.

- 26" Fir S 15E 15.3 feet to 'W' nail and tag
- 28" Fir S 86E 35.1 feet to 'W' nail and tag

Location & Comments

Corner lies approximately N15E, 15.5 feet from existing fence corner

Compass Declination 20° E

Firm/Agency Weyerhaeuser Company


Address P. O. Box 275 Springfield, Oregon 97477

Party Chief Dave Wellman

Notes _____

Witness Lee Theide

Surveyor's Seal

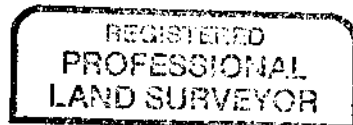

David H. Wellman

