

M107-26

FILED

JAN 9 1989

OREGON CORNER RESTORATION FORM

Section 34 Township 21 S Range 5 W

COUNTY SURVEYOR
DOUGLAS COUNTY, ORE.

County Douglas Date May 13, 1988

Corner Designation

South West Corner

- Condition Report Only
- Not Found
- Renewed
- Unrecorded
- Surveyed In
- Referenced Out

Previous Renewals/Surveys, etc.

Renewal #3, #62, # 102


Monument(s) & Accessories Found: (Condition and Source)

30" Fir	N 86E	57.2 Feet	Douglas County	CSBT 1964
26" Fir	N 54W	34.6 Feet	Douglas County	CSBT 1964
18" Fir	S 78W	44.2 Feet to 'W' Nail	Weyerhaeuser Company,	1960
18" Fir	S 70E	82.2 Feet to 'W' Nail	Weyerhaeuser Company,	1960

Monument Detail

Sketch

1" Aluminum pipe, 12" out of ground

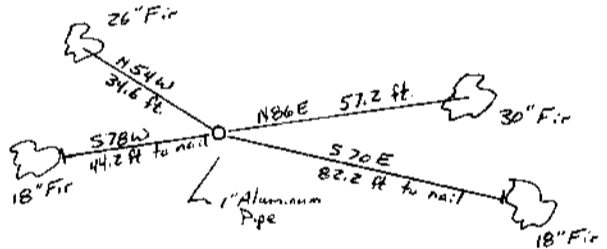

Monument Set (Procedures and Description)

None

New Accessories

None

Location & Comments

Surveyor's Seal

Compass Declination 20° E

Firm/Agency _____

Weyerhaeuser Company

Address P. O. Box 275

Springfield, Oregon 97477

Party Chief Dave Wellman

Notes _____

Witness Keith Comstock

