

FILED

FEB 6 1989

OREGON CORNER RESTORATION FORM

Section 13 Township 32S Range 5W

COUNTY SURVEYOR  
DOUGLAS COUNTY, ORE.

County Douglas Date June 9, 1988

Corner Designation

11 | 12  
14 | 13

- Condition Report Only
- Not Found
- Renewed
- Unrecorded
- Surveyed In
- Referenced Out

Previous Renewals/Surveys, etc.


Douglas County Surveyor (John Powell) 1967, & others

Monument(s) & Accessories Found: (Condition and Source)

- 3/4" Iron Pipe Found, from which a:
- 16" Fir BT, face overgrown, bears S51°E, 57.4 feet\*
- \*(Powell's Record 54.0 Ft., but Byron, 1956, shows 57.4 ft.)
- 18" D. Fir BT, face overgrown, bears N65°E, 15.0 feet.
- 14" W. Oak BT, face rotted out, bears N35 3/4°W, 8 1/2 ft., as per
- record by County Surveyor Frear, 1920.
- 16" Ponderosa Pine, <sup>8 1/2</sup> scribes visible, bears S88°W, 28.8 feet. #153
- Sectional Corner is at Fence Corner, with Fence going both South & West.

Monument Detail

Sketch

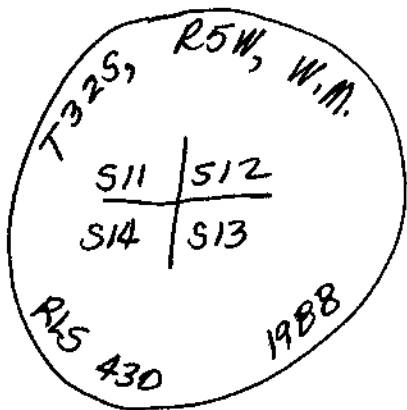

← Brass Cap Marked:

Monument Set (Procedures and Description)

I Set 2 1/2" Brass Cap, mounted on a 2" x 30" galvanized iron  
pipe, 24" in the ground, in place of 3/4" Iron Pipe.  
Reset 3/4" I. Pipe alongside Brass Cap.

New Accessories

None.

Location & Comments

Surveyor's Seal

Compass Declination 20°E

Firm/Agency

Shaner Engineering, Inc.

Address P.O. Box 1430

Roseburg, Oregon 97470

Party Chief Bruce Shaner

Notes

Witness Harry Heistein



Bruce A. Shaner



C.S. File No. 63/85-11

#2274