

FILED

APR 19 1989

OREGON CORNER RESTORATION FORM

Section 3 Township 32S Range 7W

County Douglas Date April 17, 1989

COUNTY SURVEYOR
DOUGLAS COUNTY, ORE.

Corner Designation

S4	S3
S9	S10

Condition Report Only
 Not Found
 Renewed
 Unrecorded
 Surveyed In
 Referenced Out

Previous Renewals/Surveys, etc.

U. S. B. L. M. Renewal, 1964

Douglas County Surveyor Renewal, 1967

Monument(s) & Accessories Found: (Condition and Source)

I found a 3 1/4" U.S.B.L.M. Brass Cap on a 2 1/2" x 32" galv. iron pipe, from which a:

32" D. Fir BT, now a stump, with all scribes visible and well pitched over, bears N81°W, 38.3 feet.

12" D. Fir BT, now snag in rotten condition (was 16"), scribes rotted off, bears N32°E, 16.5 feet.

16" D. Fir BT, now rotten stump, scribes gone, bears S70°E, 13.9 feet (record 13.2 feet).


20" D. Fir BT, now 10 foot high snag, scribes were burnt off, so I rescribed "T32S R7W S9 BT", bears S54°W, 13.2 feet.

8" D. Fir BT, S48°E, 20.8 feet, is now gone.

22" D. Fir BT, now stump, with scribes gone, I rescribed "T32S R7W S3 BT", bears N11 1/2°E, 40.6 feet (record 42.3 feet).

16" D. Fir BT, now stump with scribes visible, bears S30°W, 28.4 feet (record 30.0 feet).

Monument Detail & Sketch:

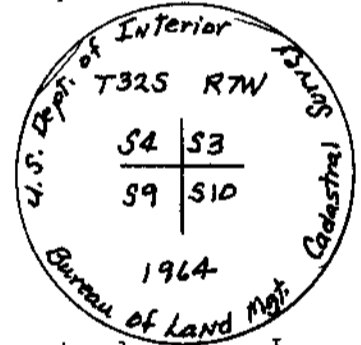

Monument Set (Procedures and Description)

Corner area was recently logged over. Prior to logging I tied all bearing trees from existing brass cap and made additional references, then removed brass cap. After logging I replaced brass cap in exactly same place and rescribed some trees as necessary and added new one. All green trees now gone.

New Accessories

36" D. Fir Stump BT, I scribed "T32S R7W S10 BT", bears S39°E, 32.5 feet. Put fence post, steel, & tag alongside brass cap.

Location & Comments

Corner lies approx. 150 feet North of landing on main spur road.

Surveyor's Seal

Compass Declination 20°E

Firm/Agency Shaner Engineering

Address P. O. Box 1430

Roseburg, Oregon 97470

Party Chief B. Shaner

Notes

Witness Jack Wright

REGISTERED
PROFESSIONAL
LAND SURVEYOR

Bruce A Shaner

OREGON
OCT. 4, 1967
BRUCE A SHANER
430

C.S. File No. 63/85C¹²

#118 +