

M 108-12

FILED

*JS*

MAY 31 1989

OREGON CORNER RESTORATION FORM

Section 19 Township 21S Range 4W

County Douglas Date 01-05-89

COUNTY SURVEYOR  
DOUGLAS COUNTY, ORE.

CORNER DESIGNATION

East 1/16 Corner  
North Line Section 19

- Condition Report Only
- Not Found
- Renewed
- Unrecorded
- Surveyed In
- Referenced Out

Previous Renewals/Surveys, etc. Survey RM-2-17 by Bruce Shaner filed 02-16-62 and Survey M103-9 by Bill Guile in 1986

Monument(s) & Accessories Found: (Condition and Source)

Found 1" Aluminum pipe set in C.S. RM-2-17.


34" Fir, N08W, 85.2' (Scar Vis.), 1962 BT. Rec. N05W, 84.9'

36" Fir, S65W, 22.1' (Scar Vis.), 1962 BT. Rec. S65W, 21.6'

9" White Fir, N65E, 12.2' (Scribe Vis.), 1986 BT. Rec. N65 1/2 E, 11.8'

10" Fir, S19E, 14.3' (Scribe Vis.), 1986 BT. Rec. S18 1/2 E, 14.3'

Monument Detail

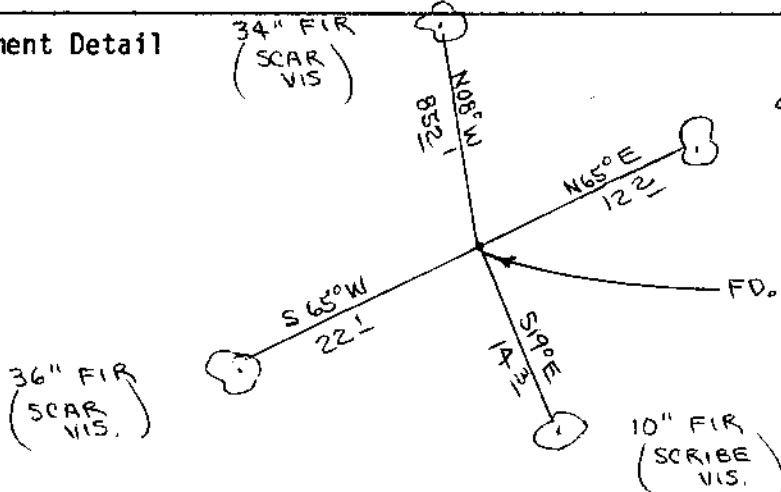

Sketch

9" WHITE FIR  
(SCRIBE VIS.)

1" ALUMINUM  
PIPE SET IN  
C.S. RM-2-17

Monument Set (Procedures and Description)

New Accessories

None

Location & Comments

Corner lies on East slope about 250' Compass Declination 20 1/2  
East of dirt road Firm/Agency Roberts Surveying Inc.  
 Address 29 West 29th St. Eugene, Oregon 97405  
 Party Chief Ted Baker  
 Notes Les Roberts  
 Witness Norman Hamar

Surveyor's Seal



C.S. File No. 63/85-15