

M108-12

FILED

MAY 31 1989

OREGON CORNER RESTORATION FORM

Section 19 Township 21S Range 4W

County Douglas Date 01-05-89

COUNTY SURVEYOR
DOUGLAS COUNTY, ORE.

CORNER DESIGNATION
Center-East 1/16
Corner Section 19

- Condition Report Only
- Not Found
- Renewed
- Unrecorded
- Surveyed In
- Referenced Out

Previous Renewals/Surveys, etc. Survey RM-2-17 by Bruce Shaner filed 02-16-62 and Survey M103-9 by Bill Guile in 1986.

Monument(s) & Accessories Found: (Condition and Source)

Found 1" iron pipe with yellow plastic cap set in C.S. M103-9.


12" Fir, S86E, 30.5' (Scar Vis.), 1962 BT, Rec. S85E, 30.4'

38" Double Maple, S51W, 31.4' (Scribe Vis.), 1962 BT, Rec. S49W, 30.9'

11" Fir, N20E, 8.8' (Scribe Vis.), 1986 BT, Rec. N20 1/2 E, 8.7'

Monument Detail

FD. 1" IRON PIPE
SET IN C.S.
M 103-9

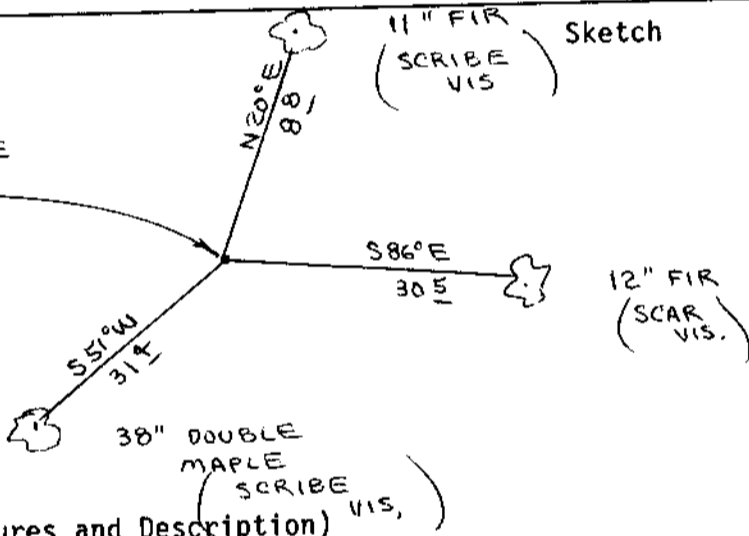

Monument Set (Procedures and Description)


New Accessories

None

Location & Comments

Surveyor's Seal

Compass Declination 20 1/2
 Firm/Agency Roberts Surveying Inc.
 Address 29 West 29th St.
Eugene, Oregon 97405
 Party Chief Ted Baker
 Notes Ted Baker
 Witness Norman Hamar

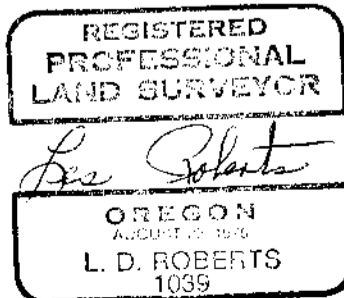

C.S. File No. 63/85-16