

M108-12

FILED

JR

MAY 31 1989

OREGON CORNER RESTORATION FORM

Section 19 Township 21S Range 4W

County Douglas Date 02-10-89

COUNTY SURVEYOR  
DOUGLAS COUNTY, ORE.

CORNER DESIGNATION

S.E. 1/16 Corner  
Section 19


- Condition Report Only
- Not Found
- Renewed
- Unrecorded
- Surveyed In
- Referenced Out

Previous Renewals/Surveys, etc. Survey RM-2-17 by Bruce Shaner filed 02-16-62. Survey M43-28 by Victor McLind filed 08-12-71.

Monument(s) & Accessories Found: (Condition and Source)

No Monument found.

Monument Detail

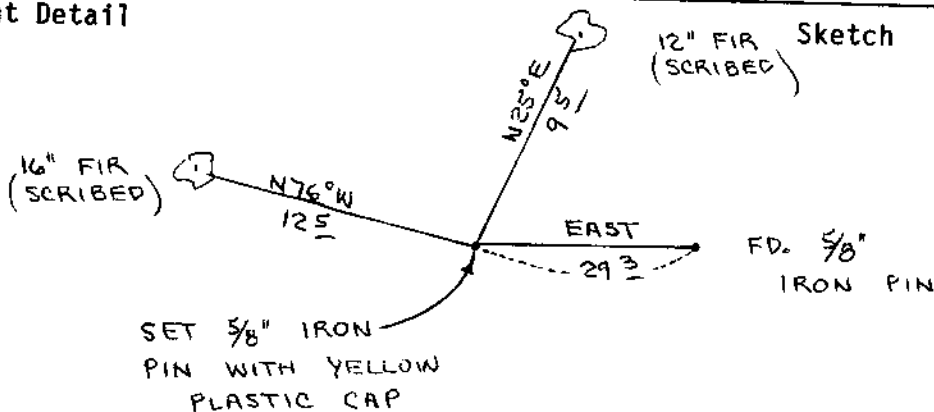

Monument Set (Procedures and Description)

Set 5/8" x 30" iron pin with yellow plastic cap. See filed survey for survey procedures. A 5/8" iron pin set in C.S. M43-28 bears East, 29.3'


New Accessories

- 12" Fir, N25E, 9.5' (Scribed/Painted Red)
- 16" Fir, N76W, 12.5' (Scribed/Painted Red)

Location & Comments

Compass Declination 20 1/2  
 Firm/Agency Roberts  
Surveying Inc.  
 Address 29 West 29th St.  
Eugene, Oregon 97405  
 Party Chief Ted Baker  
 Notes \_\_\_\_\_  
 Witness Norman Hamar

Surveyor's Seal

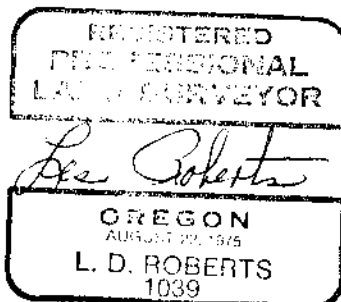

C.S. File No. 63/85-17