

M108-12

FILED

MAY 31 1989

OREGON CORNER RESTORATION FORM

Section 19 Township 21S Range 4W

County Douglas Date 01-06-89

COUNTY SURVEYOR  
DOUGLAS COUNTY, ORE.

CORNER DESIGNATION

Center-South 1/16  
Corner Section 19

- Condition Report Only
- Not Found
- Renewed
- Unrecorded
- Surveyed In
- Referenced Out

Previous Renewals/Surveys, etc. Survey RM-2-17 by Bruce Shaner filed 02-16-62.


Monument(s) & Accessories Found: (Condition and Source)

Found 1" aluminum pipe set in C.S. RM-2-17

18" Fir, S88E, 23.9' (Scar Vis.), 1962 BT. Record S87E, 23.3'

Monument Detail

Sketch

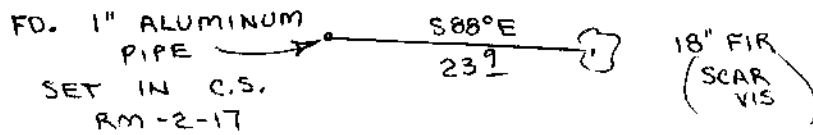

Monument Set (Procedures and Description)

New Accessories

None

Location & Comments

Surveyor's Seal

Compass Declination 20 1/2


Firm/Agency Roberts Surveying Inc.

Address 29 West 29th St. Eugene, Oregon 97405

Party Chief Ted Baker

Notes Ted Baker

Witness Norman Hamar

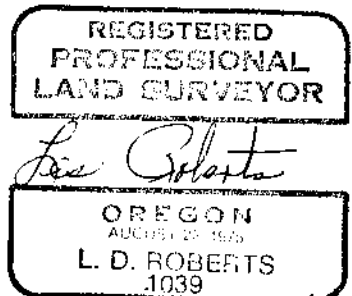

C.S. File No. 63/85-18