

M108-12

FILED

MAY 31 1989

OREGON CORNER RESTORATION FORM

Section 19 Township 21S Range 4W

County Douglas Date 01-03-89

COUNTY SURVEYOR  
DOUGLAS COUNTY, ORE.

CORNER DESIGNATION

South  $\frac{1}{4}$  Corner  
Section 19

- Condition Report Only
- Not Found
- Renewed
- Unrecorded
- Surveyed In
- Referenced Out

Previous Renewals/Surveys, etc. Survey RM-2-17 by Bruce Shaner filed 02-16-62.

#45

Monument(s) & Accessories Found: (Condition and Source)


Found  $1\frac{1}{4}$ " x  $1\frac{1}{4}$ " square headed bolt as described in C.S. RM-2-17  
18" Fir Stump, N74W, 30.6' (Scribe Vis.), 1962 BT. Rec. N74W, 30.2'  
36" Fir, S20E, 3.9' (Scar Vis.), 1962 BT. Rec. S20E, 2.8'

Monument Detail

Sketch

18" FIR STUMP (SCRIBE VIS.)

FD.  $1\frac{1}{4}$ " x  $1\frac{1}{4}$ " SQUARE HEADED BOLT

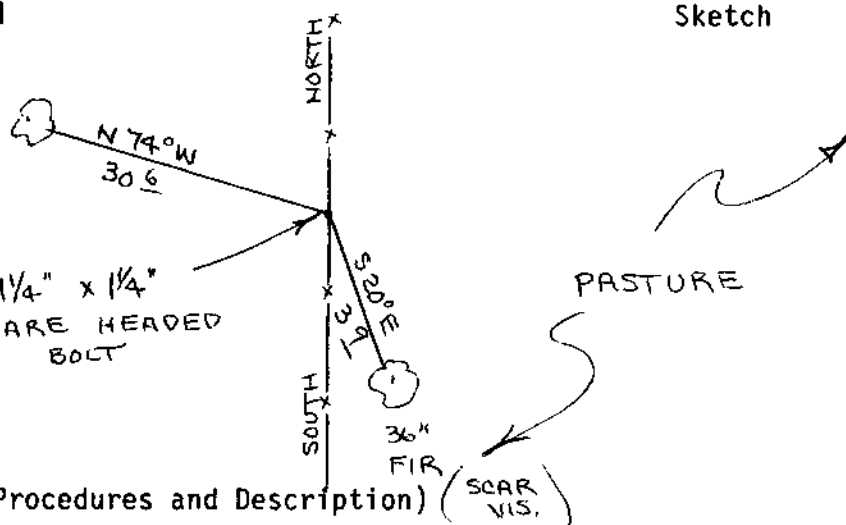

Monument Set (Procedures and Description)

New Accessories

None

Location & Comments

Corner lies on S.W. slope at West edge of pasture. Fence line runs North-South.

Compass Declination  $20\frac{1}{2}$   
Firm/Agency Roberts Surveying Inc.  
Address 29 West 29th St. Eugene, Oregon 97405  
Party Chief Les Roberts  
Notes Ted Baker  
Witness Norman Hamar

Surveyor's Seal



C.S. File No. 63/85-19