

M108-12

FILED  
MAY 31 1989

OREGON CORNER RESTORATION FORM  
Section 19 Township 21S Range 4W  
County Douglas Date 01-04-89

COUNTY SURVEYOR  
DOUGLAS COUNTY, ORE.

CORNER DESIGNATION

East  $\frac{1}{4}$  Corner  
Section 19

- Condition Report Only
- Not Found
- Renewed
- Unrecorded
- Surveyed In
- Referenced Out

Previous Renewals/Surveys, etc. Survey RM-2-17 by Bruce Shaner filed 02-16-62. Survey M43-28 by Victor McLind filed 08-12-71.

Monument(s) & Accessories Found: (Condition and Source)


Found 5/8" iron pin set in C.S. RM-2-17

36" Fir, N38W, 35.8' (Scar Vis.), 1962 BT. Rec, N37W, 35.0'

50" Double Cedar, N88E, 35.2' (Scar Vis.), 1962 BT. Rec. East, 35.1'

Monument Detail

36" FIR  
(SCAR VIS.)

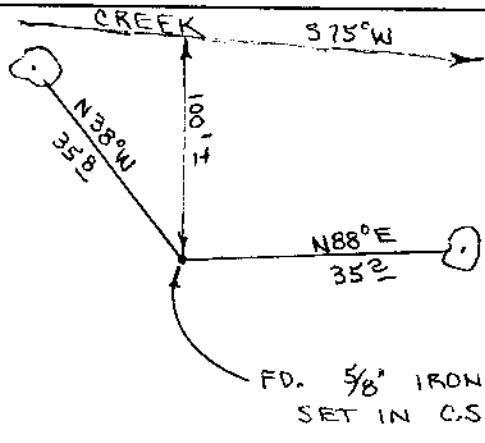

Sketch

50" DOUBLE CEDAR  
(SCAR VIS.)

Monument Set (Procedures and Description)

New Accessories

None

Location & Comments

Corner lies on North slope about 100' South of small creek

Compass Declination 20 $\frac{1}{2}$

Firm/Agency Roberts Surveying Inc.


Address 29 West 29th St. Eugene, Oregon 97405

Party Chief Les Roberts

Notes Ted Baker

Witness Norman Hamar

Surveyor's Seal

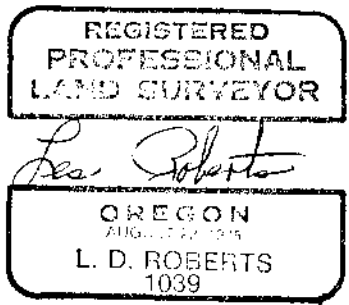

C.S. File No. 63/85-21