


CERTIFIED RECORD OF LAND CORNER MONUMENTATION

History of original corner establishment:

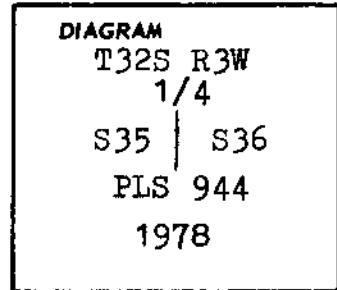

FILED

JL

JUL 19 1989

**COUNTY SURVEYOR
DOUGLAS COUNTY, ORE.**

*(No Records in
Douglas Co.)*

Description of corner evidence found:

A 2" iron pipe with 3" brass cap in stone mound and marked as shown in diagram, from which:

- A 16" Fir snag bears S74°W, 42.5 feet. (vis. scribe)
- A 8" Hemlock, dead & down, bears N18°E, 14.6 feet.
- A 40" D. Fir stump bears S67°E, 14.5 feet.

Description of monument and accessories I established to perpetuate the original location of this corner

(New Bearing Objects)

- A 40" D. Fir stump bears S60°E, 15.1 feet. (This stump was orig. B.T.)
- A 36" D. Fir stump bears N72°W, 40.7 feet.

Bearings and distances are to 40d spike set in top of stumps.

Note: No live BT's available due to Angel fire.

I hereby certify the above corner was perpetuated as hereon described in April, 1989. Bearing Tree signs and monument signs were placed on all Bearing trees and Bearing Object and face blazes were painted on all BT's.

**REGISTERED
PROFESSIONAL
LAND SURVEYOR**

Gerald V. Nygren

**OREGON
GERALD V. NYGREN
AUGUST 22, 1975
1035**

Office of Surveyor County of Douglas
 State of Oregon , I hereby certify that the within instrument was filed in this office
 for record on the 19th day of July 1989, at o'clock m., (signed)
 Fritz Ingram by *Therese A. Ferguson*
 (COUNTY OFFICIAL) (DEPUTY)

#2344