


CERTIFIED RECORD OF LAND CORNER MONUMENTATION

(T32S R1W WM)

History of original corner establishment:

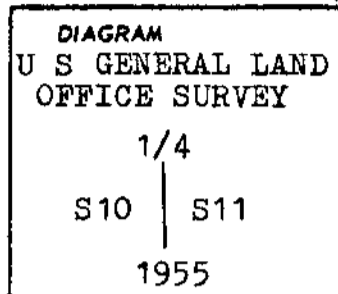

FILED

AUG 7 1989

COUNTY SURVEYOR
DOUGLAS COUNTY, ORE.

Description of corner evidence found:

Found 1" iron pipe with 2 1/2" brass cap extended 5" above ground, marked as shown in diagram, from which bears:

- A 18" D. Fir bears N85°E, 8.4 feet (healed blaze)
- A 26" D. Fir bears S8 1/4°E, 16.7 feet (healed blaze)
- A 22" D. Fir stump bears S72°W, 16.6 feet (healed blaze)

Description of monument and accessories established to perpetuate the original location of this corner

(New BT) A 6" D. Fir bears N64°W, 8.9 feet scribed "1/4 S10 BT" with 1/2" dia. brass washer marked "LS 1035" nailed to lower blaze.

I hereby certify the above corner was perpetuated as shown hereon in July 1989. Bearing tree signs and monument signs were placed on all BT's without them and a 6" band and face blazes were painted with red paint on all bearing trees.

REGISTERED
PROFESSIONAL
LAND SURVEYOR

OREGON
GERALD V. NYGREN
AUGUST 22, 1975
1035

Office of Surveyor County of Douglas
 State of Oregon I hereby certify that the within instrument was filed in this office
 for record on the 7 day of August, 1989, at o'clock m., (signed)
 Fritz Ingram by Virginia A. Lingen
 (COUNTY OFFICIAL) (DEPUTY)

#105*

Form R6-7100-57 (9/66)

C.S. File No. 63/85-28C