


CERTIFIED RECORD OF LAND CORNER MONUMENTATION

History of original corner establishment:

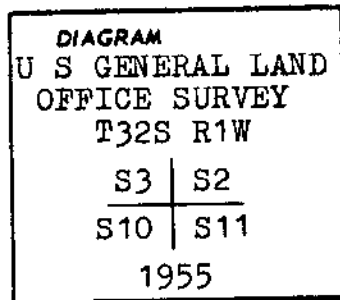

FILED

*JH*

AUG 7 1989

COUNTY SURVEYOR  
DOUGLAS COUNTY, ORE.

Description of corner evidence found:

Found 1 1/2" iron pipe with 2 1/2" brass cap marked as shown in corner diagram, from which bears:

- A 48" Fir snag, N70°E, 34.8 feet (healed blaze)
- A 36" Fir, S79°E, 67.8 feet (healed blaze)
- A 63" Fir stump, S75°W, 11.2 feet (healed blaze)
- A 30" Fir, N65°W, 82.5 feet (healed blaze)
- A 46" Fir, N50°W, 22.6 feet (healed blaze)

NOTE: Above monument (iron pipe) is badly bent.

Description of monument and accessories established to perpetuate the original location of this corner

(new BT) A 7" Fir, S46°W, 6.0 feet scribed "T32S R1W S10 BT"  
Nailed 1/2" dia. brass washer marked "LS 1035" to lower blaze.

I hereby certify the above corner was perpetuated as hereon described in July, 1989. Bearing tree signs and monument signs were placed on all BT's without them and a 6" band and face blazes were painted with red paint on all bearing trees.

REGISTERED  
PROFESSIONAL  
LAND SURVEYOR

*Gerald V. Nygren*

OREGON  
GERALD V. NYGREN  
AUGUST 22, 1975  
1035

Office of Surveyor ..... County of Douglas  
 State of Oregon ..... I hereby certify that the within instrument was filed in this office  
 for record on the 7 day of August ..... 19 89, at ..... o'clock ..... m., (signed)  
 Fritz Ingram ..... by *Virginia C. Ferguson*  
 (COUNTY OFFICIAL) (DEPUTY)

# 1034