


COPY

CERTIFIED RECORD OF LAND CORNER MONUMENTATION

History of original corner establishment:

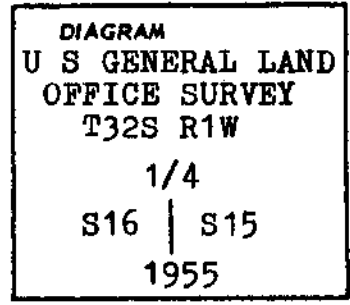

FILED *JR*  
AUG 7 1989

COUNTY SURVEYOR  
DOUGLAS COUNTY, ORE.

Description of corner evidence found:

Found 1" iron pipe with 2 1/2" brass cap extended 7" above ground and marked as shown in diagram, from which bears:

- A 8" D. Fir stump, N76 1/2° W, 16.9 feet. (REC. N77° W, 15.8 FT)
- A 34" D. Fir stump, N56 1/2° W, 17.9 feet. (REC. N55 1/2° W, 17.2 FT)
- A 33" D. Fir stump, S55 1/2° E, 36.2 feet. (REC. S55 1/2° E, 36.3 FT)
- A 22" D. FIR DEAD & DOWN, N62° E, 23.7 Ft. (VIS. SCRIBER)

*This info. Added by G. Nygren Rec'd 8/29/89*

Description of monument and accessories I established to perpetuate the original location of this corner

(New BT's) A 9" D. Fir, N89° E, 31.7 feet scribed "1/4 S15 BT"  
A 8" W. Fir, S72° W, 61.1 feet scribed "1/4 S16 BT"  
nailed 1/2" dia. brass washer marked "LS 1035" to lower blaze of new BT's.

I hereby certify the above corner was perpetuated as hereon described in May, 1989. Bearing tree signs and monument signs were placed on all BT's without them and a 6" band and face blazes were painted with red paint on all bearing trees.

REGISTERED PROFESSIONAL LAND SURVEYOR

*Gerald V. Nygren*  
OREGON  
GERALD V. NYGREN  
AUGUST 22, 1975  
1035

Office of Surveyor ..... County of Douglas  
State of Oregon ..... I hereby certify that the within instrument was filed in this office  
for record on the 7 day of August ..... 1989, at ..... o'clock ..... m., (signed)  
Fritz Ingram ..... by *Virginia A. Rangan*  
(COUNTY OFFICIAL) (DEPUTY)

#1084

Form R6-7100-57 (9/66)

COPY

G.S. File No. 603/85-1  
32