


CERTIFIED RECORD OF LAND CORNER MONUMENTATION

History of original corner establishment:

FILED
JK
AUG 22 1989
COUNTY SURVEYOR
DOUGLAS COUNTY, ORE

(T32S R1W WM)

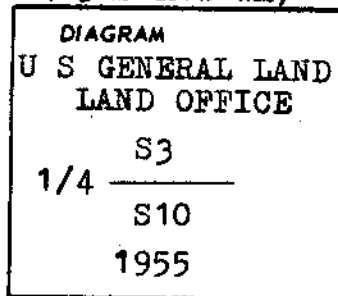

Description of corner evidence found:

Found 1" iron pipe with 2½" brass cap extended 4" above stone mound and marked as shown in diagram, from which bears:

- A 24" dia. W. Fir, S83°W, 68.0 Ft. (Rec. 89.1 Ft.) (healed blaze)
- A 22" dia. W. Fir, N17½°W, 89.1 Ft. (Rec. 68.0 Ft.) (healed blaze)
- A 32" dia. W. Fir, N40°E, 82.0 Ft. (healed blaze)
- A 26" dia. W. Fir, S70°W, 16.5 Ft. (vis. scribe)

Description of monument and accessories I established to perpetuate the original location of this corner

I hereby certify the above corner was perpetuated as hereon described in July, 1989. Bearing tree signs and monument signs were placed on all BT's without them and a 6" red band and face blazes were painted on all BT's.

**REGISTERED
PROFESSIONAL
LAND SURVEYOR**

Gerald V. Nygren
**OREGON
GERALD V. NYGREN
AUGUST 22, 1975
1035**

Office of Surveyor County of Douglas
State of Oregon, I hereby certify that the within instrument was filed in this office
for record on the 22 day of August, 19 89 at o'clock m., (signed)
Eritz Ingram by Virginia A. Raugen
(COUNTY OFFICIAL) (DEPUTY)