


CERTIFIED RECORD OF LAND CORNER MONUMENTATION

COPY

History of original corner establishment:

(T32S R1W WM)

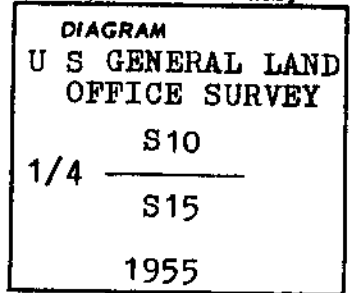

FILED *JL*
 AUG 22 1989
 COUNTY SURVEYOR
 DOUGLAS COUNTY, ORE

Description of corner evidence found:

Found 1" iron pipe with 2 1/2" brass cap extended 10" above stone mound and marked as shown in diagram, from which bears:

- A 19" dia. D. fir stump, N48 1/2° W, 72.3 Ft. (N48° W, 72.6 Ft. (REC.))
- A 50" dia. D. Fir, S16 1/2° W, 30.5 Ft. (healed blaze) (REC. S13 1/2° W, 31.0 Ft.)

NOTE: Above monument (iron pipe) has been bent.

*This info added by G. Nygren
 Rec'd 8/29/89
 JH*

Description of monument and accessories established to perpetuate the original location of this corner

(New BT) A 7" dia. D. Fir, N2° E, 28.2 Ft. scribed "1/4 S10 BT" Nailed 1/2" brass washer marked "LS 1035" to lower blaze.

I hereby certify the above corner was perpetuated as hereon described in July, 1989. Bearing tree signs and monument signs were placed on all BT's without them and a 6" red band and face blazes were painted on all BT's.

REGISTERED PROFESSIONAL LAND SURVEYOR
Gerald V. Nygren
 OREGON
 GERALD V. NYGREN
 AUGUST 22, 1975
 1035

Office of Surveyor County of Douglas
 State of Oregon, I hereby certify that the within instrument was filed in this office
 for record on the 22 day of August, 1989, at o'clock m., (signed)
Fritz Ingram by Gerald V. Nygren
 (COUNTY OFFICIAL) (DEPUTY)

COPY