


CERTIFIED RECORD OF LAND CORNER MONUMENTATION

History of original corner establishment:

**FILED**  
*ifh*  
 AUG 22 1989  
 COUNTY SURVEYOR  
 DOUGLAS COUNTY, ORE.

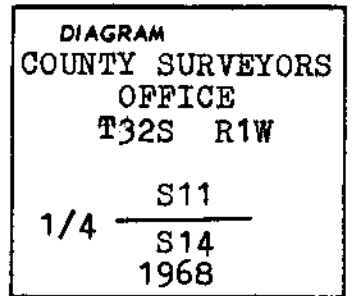

Description of corner evidence found:

Found 1" iron pipe with 2½" brass cap extended 9" above ground and marked as shown in diagram, from which bears:

- A 29" dia. D. Fir, N50°W, 4.7 Ft. (healed blaze) *Rec. 114690*
- A 11" dia. D. Fir, S4°19'E, 16.6 Ft. (vis. scribe)
- A 18" dia. D. Fir snag, S58 54'W, 17.4 Ft. *Doc. #*

*see attached sheet C563/85-39*

Description of monument and accessories I established to perpetuate the original location of this corner

(New BT) A 7" dia. D. Fir, S59°E, 35.1 Ft. scribed "1/4 S14 BT" Nailed ½" brass washer marked "LS 1035" to lower blaze.

I hereby certify the above corner was perpetuated as hereon described in July, 1989. Bearing tree signs and monument signs were placed on all BT's without them and a 6" red band and face blazes were painted on all BT's.

**REGISTERED  
 PROFESSIONAL  
 LAND SURVEYOR**

*Gerald V. Nygren*

OREGON  
 GERALD V. NYGREN  
 AUGUST 22, 1975  
 1035

Office of.....Surveyor..... County of... Douglas  
 State of... Oregon....., I hereby certify that the within instrument was filed in this office  
 for record on the 22 day of August....., 19 89, at..... o'clock.....m., (signed)  
 Fritz Ingram by *Regina A. Haugen*  
 (COUNTY OFFICIAL) (DEPUTY)

#109X