


COPY

CERTIFIED RECORD OF LAND CORNER MONUMENTATION

History of original corner establishment:

FILED  
AUG 22 1989  
COUNTY SURVEYOR  
DOUGLAS COUNTY, ORE

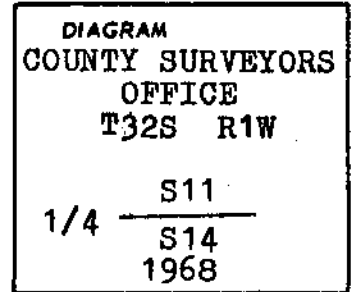

Description of corner evidence found:

Found 1" iron pipe with 2 1/2" brass cap extended 9" above ground and marked as shown in diagram, from which bears:

- A 29" dia. D. Fir, N50°W, 4.7 Ft. (healed blaze) (REC. N45°W, 4.6 Ft.)
- A 11" dia. D. Fir, S4°19'E, 16.6 Ft. (vis. scribe) (REC. S5°W, 16.6 Ft.)
- A 18" dia. D. Fir snag, S58 54'W, 17.4 Ft. (REC. S59°W, 18.3 Ft.)

*This info added by G. Nygren Rec'd 8/29/89*

Description of monument and accessories I established to perpetuate the original location of this corner

(New BT) A 7" dia. D. Fir, S59°E, 35.1 Ft. scribed "1/4 S14 BT" Nailed 1/2" brass washer marked "LS 1035" to lower blaze.

I hereby certify the above corner was perpetuated as hereon described in July, 1989. Bearing tree signs and monument signs were placed on all BT's without them and a 6" red band and face blazes were painted on all BT's.

REGISTERED PROFESSIONAL LAND SURVEYOR

*Gerald V. Nygren*

OREGON  
GERALD V. NYGREN  
AUGUST 22, 1975  
1035

Office of SURVEYOR County of Douglas  
State of Oregon, I hereby certify that the within instrument was filed in this office for record on the 22 day of August, 19 89, at          o'clock          m., (signed)  
Fritz Ingram by Gerald V. Nygren  
(COUNTY OFFICIAL) (DEPUTY)

COPY