

FILED *jh*

OREGON CORNER RESTORATION FORM

SEP 20 1989

Section 33 Township 20S Range 7W

County Douglas Date 09-02-89

COUNTY SURVEYOR  
DOUGLAS COUNTY, ORE.

CORNER DESIGNATION

Center  $\frac{1}{4}$  Corner  
Section 33

- Condition Report Only
- Not Found
- Renewed
- Unrecorded
- Surveyed In
- Referenced Out

Previous Renewals/Surveys, etc. 1984 B.L.M. Cadastral Survey.


Monument(s) & Accessories Found: (Condition and Source)

Found 1984 B.L.M. Brass Cap set firmly in the ground in recently logged unit.

11" Hemlock Stump, S84W, 48.6' (Scar Vis.), 1984 BT.

20" Fir Stump, N20W, 65.1' (Scar Vis.), 1984 BT.

Monument Detail

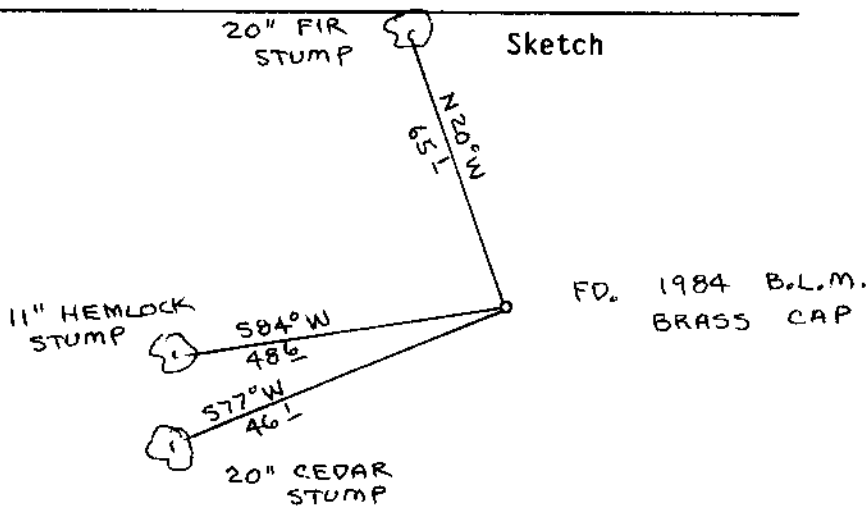

Monument Set (Procedures and Description)

New Accessories

Soaked sides and tops of stumps with a wood preservative.

Covered tops of stumps with 0.020 thick sheets of aluminum.

Set 72" aluminum post, with land survey sign bolted to, beside brass cap. Set an additional R.P., 20" cedar stump, S77W, 46.1' to spike driven into base of stump, stump not scribed.

Location & Comments

Surveyor's Seal

Compass Declination 20 $\frac{1}{2}$


Firm/Agency Roberts Surveying Inc.

Address 29 West 29th St. Eugene, Oregon 97405

Party Chief Ted Baker

Notes \_\_\_\_\_

Witness Norman Hamar

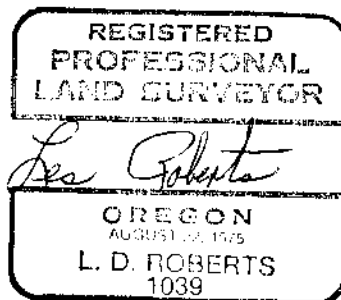

#94X

C.S. file no. 63/85-40