


**CERTIFIED RECORD OF LAND CORNER MONUMENTATION**

**History of original corner establishment:**

SAMUEL C. FLINT - DEPUTY SURVEYOR - AUG. 1882  
 CHARLES ROBERTS - RETRACEMENT - 1905  
 CHARLES COLLIER - RETRACEMENT - 1913  
 FRED MENSCH - RETRACEMENT - 1916  
 HAROLD D. CORBIN - DEPENDENT RESURVEY - 1957

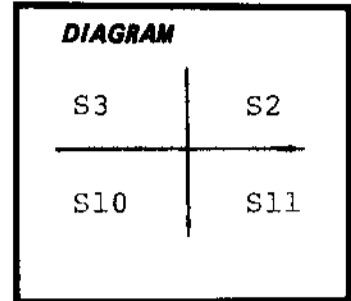

**Description of corner evidence found:**

AT THE CORNER COMMON TO SECTIONS 2,3,10,11, T. 27 S., R. 2 W., W.M., I FIND A 2 1/2" X 30" GALVANIZED IRON PIPE WITH A 3" DIAMETER BRASS CAP STAMPED: "T27S R2W" FIRMLY ATTACHED TO THE TOP. THE MONUMENT HAD BEEN RAN OVER BY 3/2 A CAT DURING RECENT LOGGING OPERATIONS AND WAS LYING ON ITS SIDE 10/11 IN RELATIVELY GOOD POSITION TO THE BEARING TREES.

- 13" HEMLOCK BEARS S. 22° W., 29.7 FEET (1962)
- 24" CEDAR BEARS N. 59° W., 49.2 FEET (1905 REC. 49.5')
- 41" FIR STUMP BEARS N. 19° E., 56.0 FEET (1905 REC. 54.8')
- 30" FIR STUMP BEARS S. 47° E., 62.9 FEET (1905 REC. S. 50° E., 62.0')
- 15" HEMLOCK (REC. FIR) BEARS N. 57°30' W., 22.3 FEET (1957 REC. 21.8' TO FACE)
- 13" FIR BEARS N. 60° E., 57.6 FEET (1957 REC. 57.4')
- 15" CEDAR BEARS S. 25° E., 19.8 FEET (1957 REC. S. 28°30' E.)

**Description of monument and accessories | established to perpetuate the original location of this corner:**

I RESET THE MONUMENT 24" IN THE GROUND AND BUILT A 36" DIAMETER STONE MOUND TO THE TOP OF THE PIPE.

**FILED**  
*LL*  
 NOV 28 1989  
 COUNTY SURVEYOR  
 DOUGLAS COUNTY, ORE.

BAUGHMAN TECHNICAL SERV.  
 P.O. BOX 222  
 ROSEBURG, OR 97470

REGISTERED  
 PROFESSIONAL  
 LAND SURVEYOR

*Glen S. Baughman*  
 GLEN S. BAUGHMAN  
 S.S.

Office of.....Surveyor..... County of...Douglas.....  
 State of...Oregon....., I hereby certify that the within instrument was filed in this office  
 for record on the...28... day of...November....., 19.89  
 ....Fritz Ingram..... by *Virginia A. Laugen*.....  
 (COUNTY OFFICIAL) (DEPUTY)