

FILED *JH*

DEC 11 1989

OREGON CORNER RESTORATION FORM

Section 31 Township 21S Range 4W

COUNTY SURVEYOR  
DOUGLAS COUNTY, ORE.

County DOUGLAS Date OCT. 31, 1989

Corner Designation

WEST 1/4 corner Sec. 31, only

- Condition Report Only
- Not Found
- Renewed
- Unrecorded
- Surveyed In
- Referenced Out

Previous Renewals/Surveys, etc.


B.L.M. 1988

Monument(s) & Accessories Found: (Condition and Source)

FOUND DISTURBED BRASS CAP ON A 2" ALUM PIPE,  
SHILOH LOGGING OPERATION HAD PUSHED MONUMENT IN A  
NORTHEAST DIRECTION. ALSO FOUND B.T. STUMPS WITH  
TAGS AND SCRIBES VISIBLE ON THE NW & SE B.T.'S  
AND HEALED BLAZE ON E-SE B.T., ALL STUMPS HAVE  
ALUMINUM SHEETS COVERING THEM.

Monument Detail

Sketch

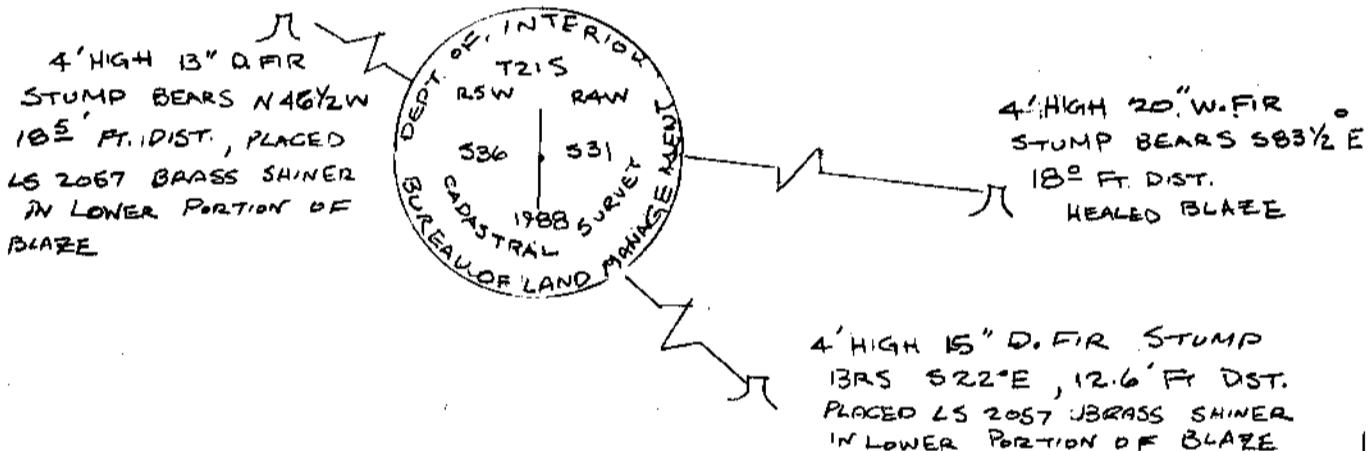

Monument Set (Procedures and Description)

I EXCAVATED THE FOUND BLM MONUMENT, & FOUND  
A 3/4\" X 34\" GAL. I. PIPE INSIDE OF MONUMENT. I WAS  
ABLE TO REESTABLISH G.I.P. POSITION AS IT WAS  
SET 3 TO 4 INCHES DEEPER THAN B.L.M. MONUMENT, I STRAIGHTEND  
BOTH MONUMENTS & RESET ACCORDINGLY.

New Accessories

NONE MARKED, AS STUMPS SHOULD  
PERPETUATE CORNER POSITION UNTIL SUITABLE TREES  
CAN BE USED, I PAINTED & RE-TAGGED B.T.  
STUMPS (\* CORNER IS NOW WITHIN A CLEAR-CUT)

Location & Comments

Surveyor's Seal

THIS 1/4 CORNER Compass Declination 18 1/2° E  
IS LOCATED WITHIN Firm/Agency SHILOH FORESTRY INC  
A CLEAR-CUT APPROX Address P.O. BOX 1479  
150' WEST OF A EUGENE ORE 97440  
QUISTINA LOGGING RD Party Chief M. STEWART  
ON A NW ASPECT. Notes SAME  
 Witness SAME

REGISTERED  
PROFESSIONAL  
LAND SURVEYOR

*Martin C. Stewart*

OREGON  
JULY 15, 1983  
MARTIN C. STEWART  
2057

#149 T21-4 +  
#169 T21-5 +