

FILED

WLR

OREGON CORNER RESTORATION FORM

JAN 27 1989

Section 17 Township 21 S Range 4 W

County Douglas Date 12/28/88

COUNTY SURVEYOR
DOUGLAS COUNTY, ORE.

Corner Designation

$\frac{1}{4}$ $\frac{8}{17}$

- Condition Report Only
- Not Found
- Renewed
- Unrecorded
- Surveyed In
- Referenced Out

Previous Renewals/Surveys, etc. # 111


Monument(s) & Accessories Found: (Condition and Source)

found monument out of position lying on top
of ground.
bearing trees
original decayed Fir stump 48" bears S74°W 126 1ks dist
NO ^{scribble} MARKS visible on opened blaze
Bts by ~~Tracy~~ Tracy 1969
A Fir 26" bears N64°E 39 1ks with healed blaze
A Fir 18" bears S29°W 52 1ks with healed blaze

Monument Detail

Sketch

COUNTY SURVEYORS
7215
 $\frac{1}{4}$ $\frac{38}{517}$
R4W
1969
Office

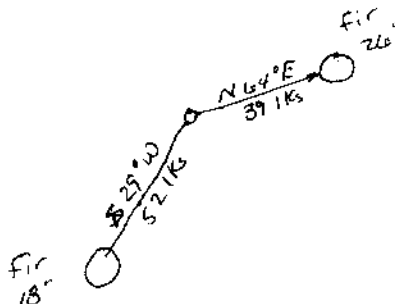

Monument Set (Procedures and Description)

drilled one inch hole 2 inches deep in bedrock
drove $\frac{3}{4}$ inch pipe into drill hole and
cemented base, drove 12 in long $\frac{1}{4}$ inch
pipe with ~~Don~~ County Surveyors Office Brass
cap over $\frac{3}{4}$ inch iron pipe.

New Accessories

Added marks RESET 1988 To B.C.

Location & Comments

corner is located in
a ravine draining
S45°W

Compass Declination 18 $\frac{3}{4}$ °

Firm/Agency BLM

Address 777 NW

Garden Valley B/UD.

Party Chief Wayne Rogers

Notes Boyd Peterson

Witness Dale Bedell

Surveyor's Seal

REGISTERED
PROFESSIONAL
LAND SURVEYOR
Wayne L Rogers
OREGON
FEBRUARY 14, 1985
WAYNE L. ROGERS
2137

1474

C.S. File No. 63/B7-1C