

FILED

FEB 17 1989

COUNTY SURVEYOR  
DOUGLAS COUNTY, ORE

OREGON CORNER RESTORATION FORM

Section 10 Township 30 S Range 4 W

County Douglas Date 5/25/88

Corner Designation

1/4  
S 10 | S 11

- Condition Report Only
- Not Found
- Renewed
- Unrecorded
- Surveyed In
- Referenced Out

Previous Renewals/Surveys, etc. \_\_\_\_\_

Monument(s) & Accessories Found: (Condition and Source)

1 1/4 ins. I.P. found firmly set proj 12" above  
g/d.

Orig BT A Pine 40" Brs S 25° W 16 1/2 IKs  
Scribe mark S visible on opened blaze.

Bts by Byron  
A Pine 16" Brs S 20° E 36 1/2 IKs fragmentary scribe  
marks visible on partially healed double blaze.

A root hole bears N 26° W 85 IKs with down pine alongside  
scribes


Monument Detail

Sketch 1/4 S10 CS BT  
visible on open  
double blaze

marked as shown

should be

S 10 | S 11

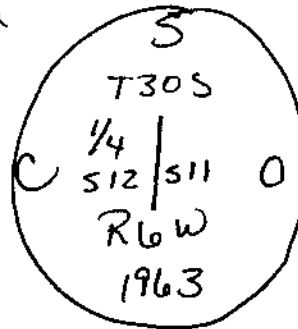

Monument Set (Procedures and Description)

\_\_\_\_\_  
\_\_\_\_\_  
\_\_\_\_\_

New Accessories

A pine, 10" Brs N 59° W, 46 IKs. dist.,  
mfd. 1/4 S 10 BT.

Location & Comments

located in  
fence

Compass Declination 19°  
Firm/Agency BLM


Address 777 NW Garden  
Valley Blvd

Party Chief Wayne Rogers

Notes \_\_\_\_\_

Witness \_\_\_\_\_

Surveyor's Seal

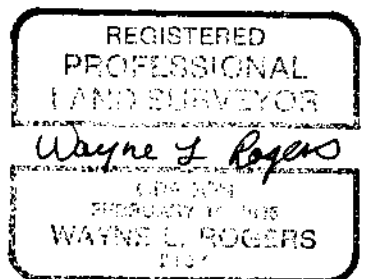

#242 4

C.S. File No. 63/87-2 C