

FILED *JR*

JUN 7 1989

OREGON CORNER RESTORATION FORM

Section 35 Township 28S Range 8W

County Douglas Date 6/1/89

COUNTY SURVEYOR
DOUGLAS COUNTY, ORE.

Corner Designation

$\frac{34}{3} \frac{35}{2}$

- Condition Report Only
- Not Found
- Renewed
- Unrecorded
- Surveyed In
- Referenced Out

Previous Renewals/Surveys, etc.

~~#25~~ T29S RBW #57 T28S RBW
43

Monument(s) & Accessories Found: (Condition and Source)

1 1/4" iron post found loosely set projecting 24 ins. above ground.

BT by Boyer A fir snag 19" brs S 70° W 77 IKs *th. per Wayne Rogers 4/6/89*

Bts by Byron


A fir 11", Bts N 2 1/2° E 25 IKs Healed double blaze

A fir, 14" brs S 8° E 46 IKs Healed double blaze

A fir, 19" brs N 4 1/4° W 36 IKs Healed double blaze

Monument Detail

Sketch

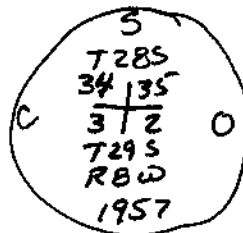

Monument Set (Procedures and Description)

Referenced monument and reset 24 ins in the ground with 8" projecting above ground

New Accessories

A fir, 19", brs S 39 1/2° W 45 IKs MKd T29S RBW S3 BT

Location & Comments

Compass Declination 18 1/4

Firm/Agency BLM

Address 777 NW Garden


Valley Blvd

Party Chief Wayne Rogers

Notes Mike Mabain

Witness Robert Browning

Surveyor's Seal

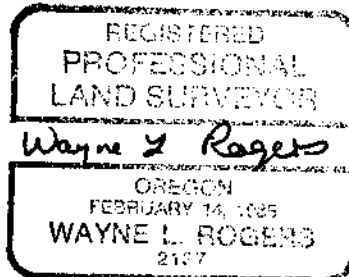

#209 T29-8X
#198 T28-8X

C.S. File No. 63/89-3 C