

FILED

JH

JUN 21 1989

OREGON CORNER RESTORATION FORM

Section 35 Township 28S Range 8W

County Douglas Date 6/20/89

COUNTY SURVEYOR
DOUGLAS COUNTY, ORE.

Corner Designation

1/4
534/535

- Condition Report Only
- Not Found
- Renewed
- Unrecorded
- Surveyed In
- Referenced Out

Previous Renewals/Surveys, etc.

4, 44

Monument(s) & Accessories Found: (Condition and Source)

County Surveyors iron post 1/4" diam. found
in top of road cut bank loosely set Proj
18 inches above grd.

Orig BT. An Oak 38 ins. diam., Brs 550°E 150 lks healed
double blaze

1934 BT by Boyer A white oak 21 ins diam brs S49 1/2°E 53
lks dist with healed double blaze Pen #4

Monument Detail

Sketch

Monument Set (Procedures and Description)

monument was referenced out and reset
projecting 6 inches above ground

New Accessories

None mkd

BTy By
Byron 1957

A cedar, 21 ins diam, brs S71 1/4°E 47 lks dist healed double blaze

A white oak, 10 ins. diam, brs S82 1/2°W 93 lks dist
with healed double blaze

Location & Comments

corner is located
in cutbank on
East edge of
Suicide Creek Rd.

Compass Declination

Firm/Agency BLM

Address 777 NW Garden


Valley Blvd

Party Chief Wayne Rogers

Notes Wayne Rogers

Witness Robert Browning

Surveyor's Seal

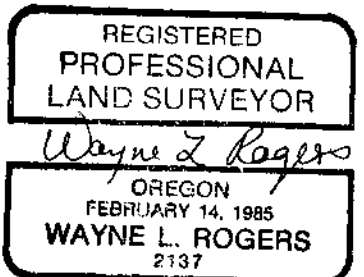

#1994

C.S. File No. 63/87-4 C