


FILED

APR 6 1989

CERTIFIED RECORD OF LAND CORNER MONUMENTATION

COUNTY SURVEYOR  
DOUGLAS COUNTY, ORE.

History of original corner establishment:

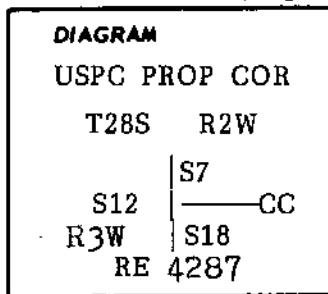

Description of corner evidence found:

- A 1" iron pipe with aluminum cap extending 6" above stone mound and marked as shown in diagram, from which:
- A 26" stump bears N32°W, 26.1 feet - visible scribing,
- A 40" Douglas fir stump bears S60°E, 29.0 feet - healed blaze,
- A 24" stump bears N82°E, (REC. N82°W), 56.1 feet,
- A 12" maple bears N49°E, 51.8 feet - visible scribing.

Description of monument and accessories established to perpetuate the original location of this corner

- (New BT) A 10" cedar bears S57°E, 19.5 feet scribed "T28S R2W S18 BT".
- A 1/2" brass washer was set in BT face marked "RLS 1035".

I hereby certify the above corner was perpetuated as hereon described on December 13 1988. Bearing tree and monument signs were placed on all BT's without them and a 6" red band and face blazes were painted on all bearing trees.

REGISTERED  
PROFESSIONAL  
LAND SURVEYOR

OREGON  
GERALD V. NYGREN  
AUGUST 22, 1975  
1035

Office of County Surveyor County of Douglas  
 State of Oregon, I hereby certify that the within instrument was filed in this office  
 for record on the 6th day of April, 1989, at     o'clock     m., (signed)  
Fritz Ingram by Virginia A. Sargent  
 (COUNTY OFFICIAL) (DEPUTY)

#150 T28-2 x  
#165 T28-3 x  
Form R6-7100-57 (9/66)

C.S. File No. 63/92-1

c