


FILED

*JH*

APR 6 1989

**CERTIFIED RECORD OF LAND CORNER MONUMENTATION**  
**COUNTY SURVEYOR**  
**DOUGLAS COUNTY, OREGON**

History of original corner establishment:

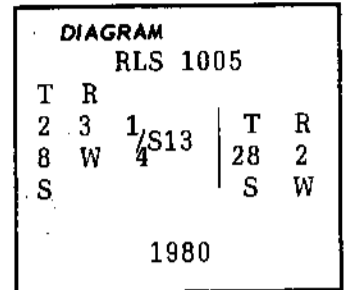

Description of corner evidence found:

- A 2½" iron pipe with brass cap extending 8" above ground and marked as shown in diagram, from which:
- A 7" hemlock bears N40°W, 10.0 feet - visible scribing,
- A 9" madrona snag bears S85°E, 7.2 feet - visible scribing.

Description of monument and accessories I established to perpetuate the original location of this corner

- (New BT) A 5" cedar bears N74°E, 11.3 feet, scribed "X BT"
- A ½" brass washer was set in BT face marked "LS 1035"

I hereby certify the above corner was perpetuated as hereon described on December 12, 1988. Bearing tree and monument signs were placed on all BT's without them and a 6" red band and face blazes were painted on all bearing trees.

**REGISTERED PROFESSIONAL LAND SURVEYOR**

*Gerald V. Nygren*

**OREGON**  
GERALD V. NYGREN  
AUGUST 22, 1975  
1035

Office of..... County Surveyor..... County of..... Douglas.....  
 State of..... Oregon....., I hereby certify that the within instrument was filed in this office  
 for record on the ..6..... day of ..April....., 19 89, at..... o'clock..... m., (signed)  
 Fritz Ingram..... by..... *Virginia A. Saenger*.....  
 (COUNTY OFFICIAL) (DEPUTY)

#164 T28-3 + Form R6-7100-57 (9/66)  
#149 T28-2 +

C.S. File No. 63/92-2