

FILED

MAR 8 1990

OREGON CORNER RESTORATION FORM

Section 18 Township 29S Range 6W

County Doug/95. Date 3-6-90

COUNTY SURVEYOR
DOUGLAS COUNTY, ORE.

Corner Designation

SW Sec Corner.

- Condition Report Only
- Not Found
- Renewed
- Unrecorded
- Surveyed In
- Referenced Out


Previous Renewals/Surveys, etc. 1957 CAD

Monument(s) & Accessories Found: (Condition and Source)

- IPBC 1957 CAD
- 11" Fir N52W 79° rotting open face 1910 CAD
- 8" (now 20") Fir N47W 91° Healed face 1957 CAD
- 17" Madrone S82E 62° visible scribe 1957 CAD
- 20" Fir S44 1/2 W 17° Rotted open face 1910 CAD

Monument Detail

Sketch

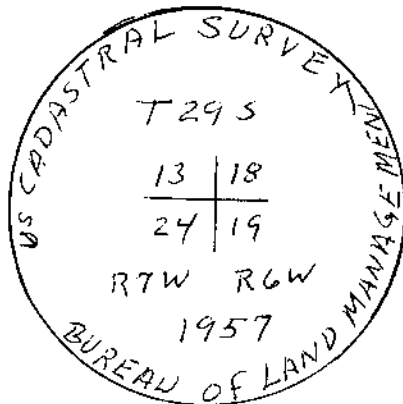

Monument Set (Procedures and Description)

New Accessories

- 6" Fir N84E 12°
- 14" W Fir S52E 8°

Location & Comments

Surveyor's Seal

Compass Declination 20°
 Firm/Agency Roseburg Resources
 Address P.O. Box 1088
Roseburg, OR 97470
 Party Chief Floyd White
 Notes Bill Olson
 Witness _____

REGISTERED
PROFESSIONAL
LAND SURVEYOR

OREGON
MAY 13, 1960
HOWARD W. JOHNSTONE
498

293 T29-7 X
272 T29-6 X