

**PROPERTY SURVEY IN LOTS 7 & 8, BLOCK
21, SOUTHERN DRAIN ADDITION, IN
THE N. 1/2, SECTION 17, T.22S., R.5W.,
W.M., DRAIN, OREGON**

FOR · J. TAYLOR
585 S. ESPEY RD.
GRANTS PASS, OR
97526

BY · ROBERT L. DOLAN
RT. 1, BOX 1820
SUTHERLIN, OR
97479


DATE · JUNE 1989

SCALE · 1" = 100'

Legend ·

- FD. AS NOTED
- SET 5/8" X 30" IRON ROD W/CAP

COUNTY SURVEYORS FILE DATA
DO NOT REMOVE FROM OFFICE

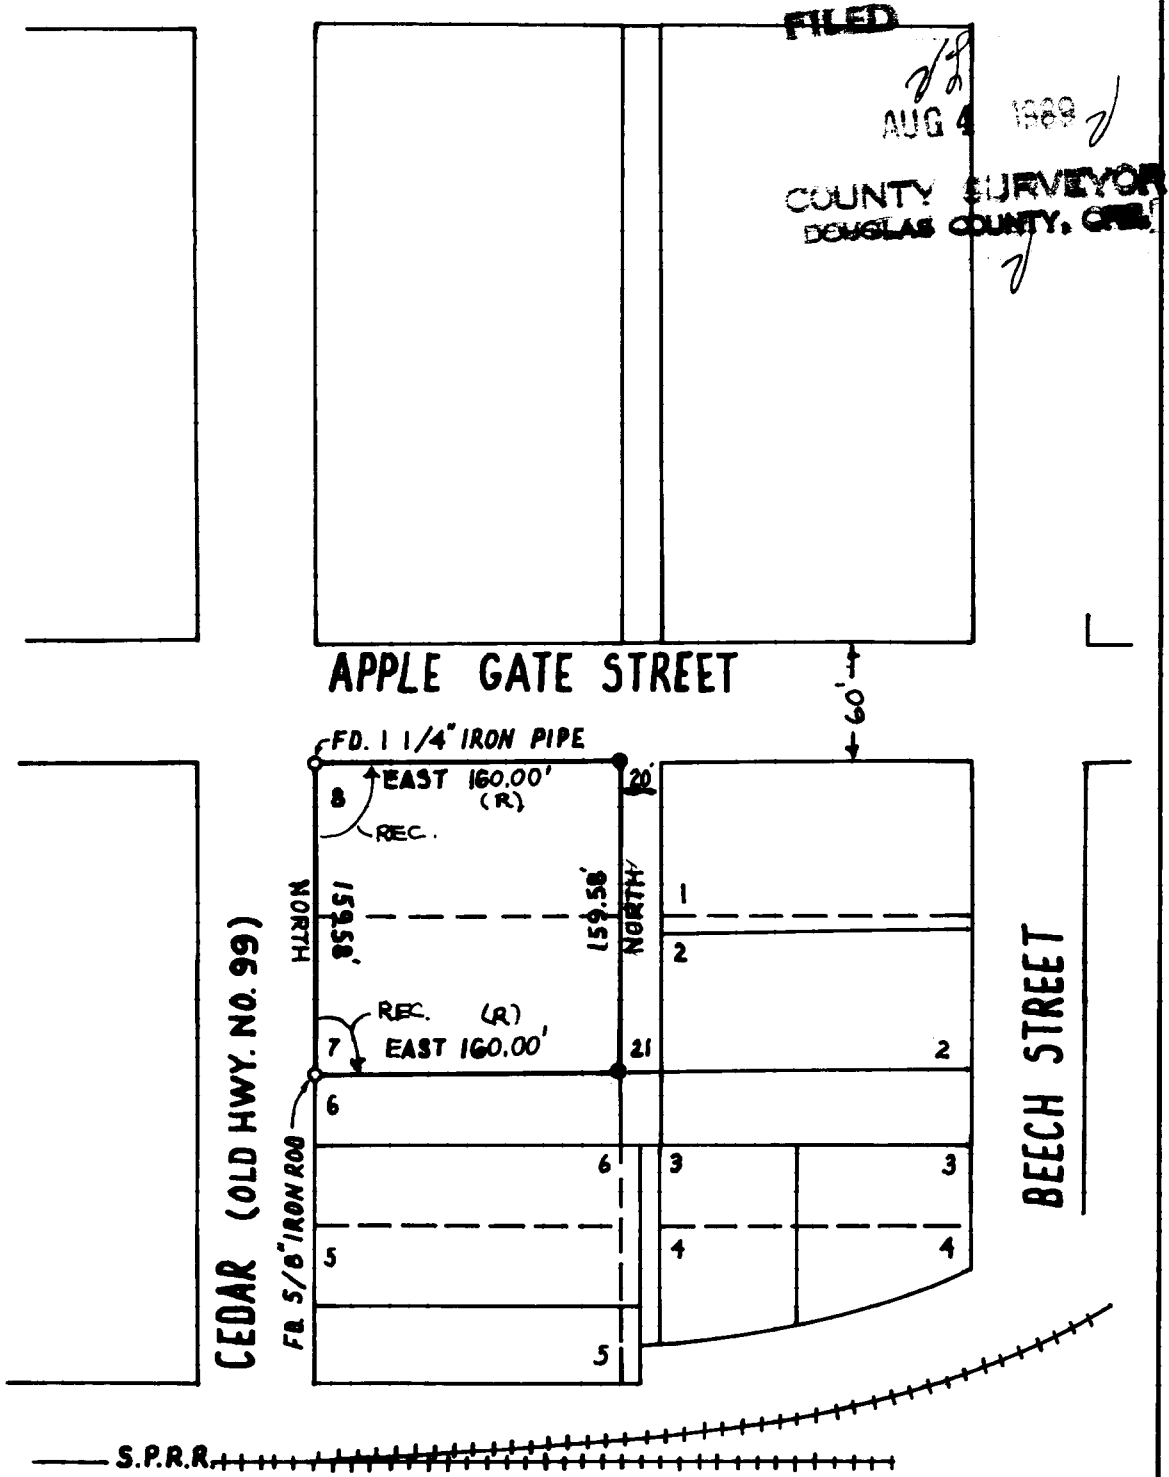

BASE BEARING
PLAT MAP

NARRATIVE ·

SURVEY TO MONUMENT PROPERTY CORNERS
FROM FOUND PROPERTY PINS.

INSTRUMENTS ·

THEODOLITE - DISTANCE METER

REGISTERED
PROFESSIONAL
LAND SURVEYOR

Robert L. Dolan

OREGON
JULY 30, 1976
ROBERT L. DOLAN
1076