




Station: RSBG 67. T 26 S, R 5 W , Sec 7
 Set By (Agency): CITY(RSBG)
 Date Set: 1/89
 Recovered By _____
 Date Recovered _____
 Recovered By _____
 Date Recovered _____
 Recovered By _____
 Date Recovered _____

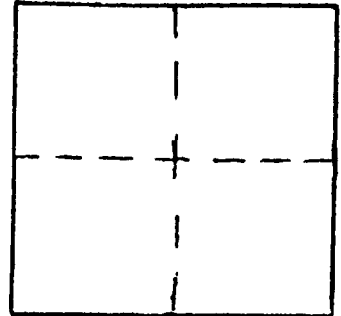

VERTICAL CONTROL

Elevation: 518.13 NGS Line # _____ USGS Line # _____ OSHD Line # _____
 Precision: _____ Agency: _____ Proj. # _____ Date: _____

HORIZONTAL CONTROL

South Zone State Plane Coordinates: Y(Northing) 615,979.24 X(Easting) 1,246,039.04
 Precision: 1/20,000 Agency: CITY(RSBG) Proj. # _____ Date: _____
 Approximate Geographic Position: Latitude 43°19'19" Longitude 123°20'02"


DESCRIPTION and TO REACH

SKETCH

Brass cap stamped "RSBG 67"
 set flush in concrete.

TO REACH:

Go up driveway just South of
 Wilber Post Office to trailer
 house at end of road. Go through
 gates past barns to fork in road.
 Monument is about 100 feet
 Northeast of fork in road.

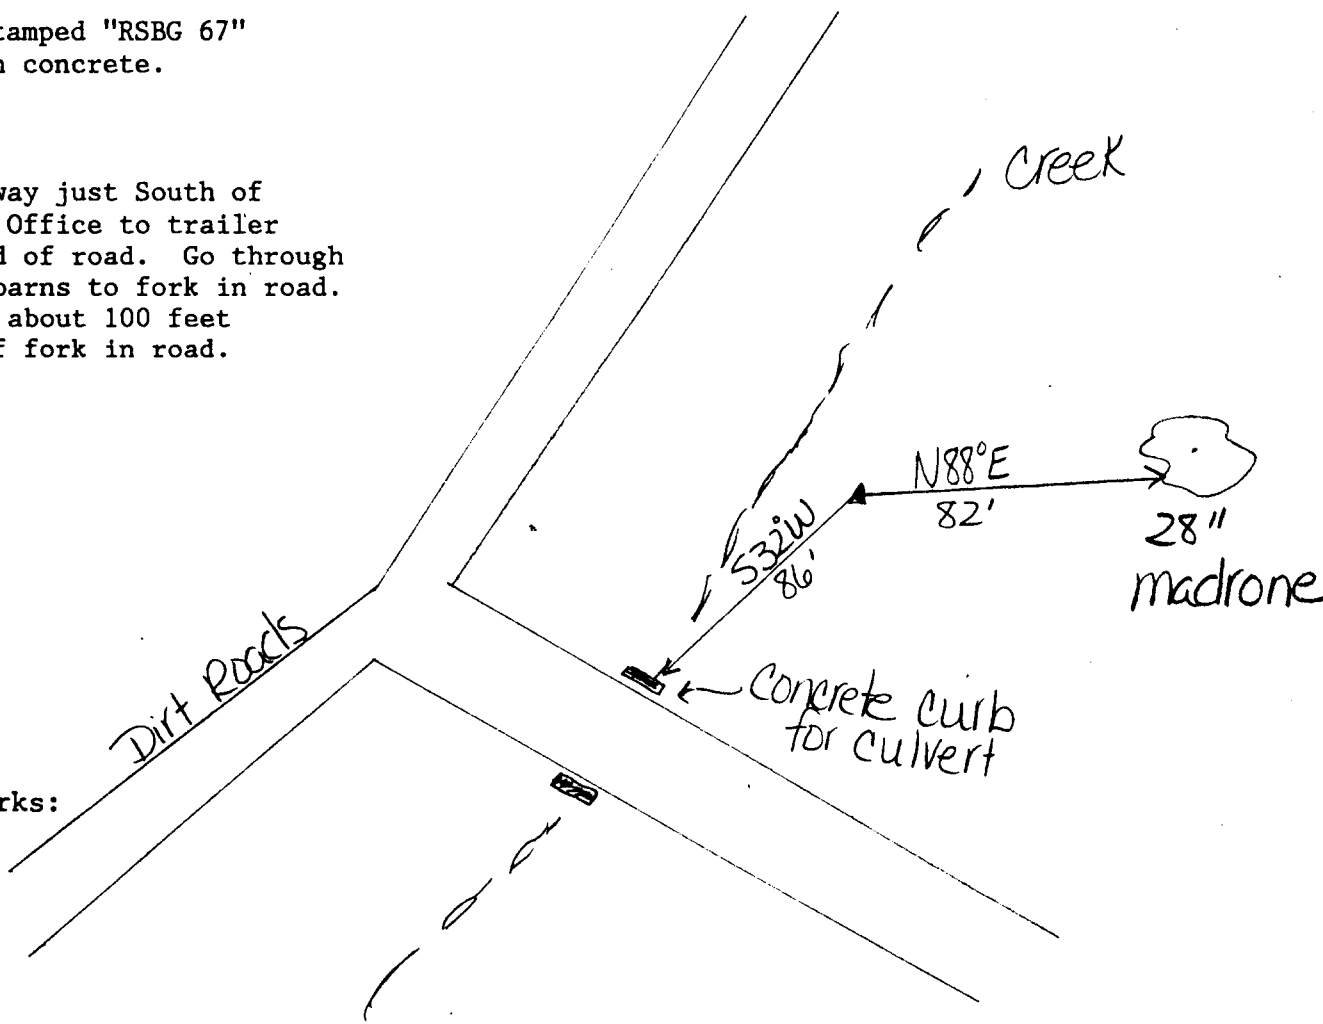

Reference Marks: