




Station: RSBG 63 T 26 S, R 5 W, Sec 20
Set By (Agency): CITY(RSBG)
Date Set: 1/89
Recovered By _____
Date Recovered _____
Recovered By _____
Date Recovered _____
Recovered By _____
Date Recovered _____

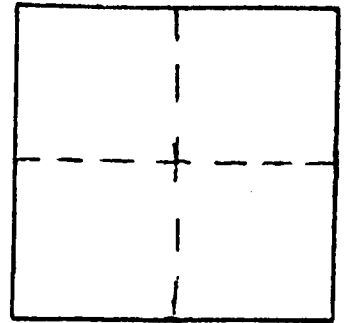

VERTICAL CONTROL

Elevation: 592.63 NGS Line # _____ USGS Line # _____ OSHD Line # _____
Precision: _____ Agency: _____ Proj. # _____ Date: _____

HORIZONTAL CONTROL

South Zone State Plane Coordinates: Y(Northing) 605,454.08 X(Easting) 1,248,841.66
Precision: 1/20,000 Agency: CITY(RSBG) Proj. # _____ Date: _____
Approximate Geographic Position: Latitude 43°17'36" Longitude 123°19'19"


DESCRIPTION and TO REACH

SKETCH

Alum. cap stamped "RSBG 63"
on 5/8" rebar flush with
a/c on Page Road

TO REACH:

From the intersection of #99 and
Page Road proceed easterly
along Page Road approximately
2.3 miles to top of grade monument
is in left edge of pavement.

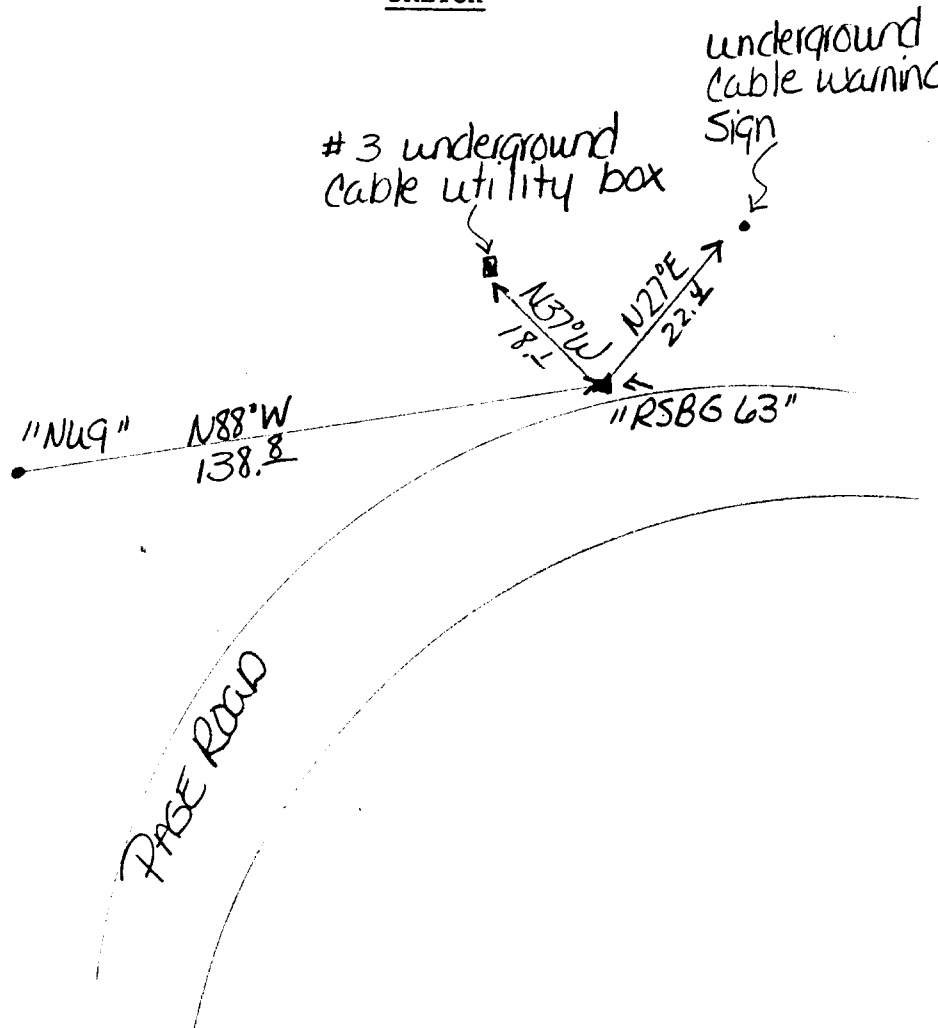

Reference Marks: