




Station: RSBG 62 T 26 S, R 5 W, Sec 29
 Set By (Agency): CITY (RSBG)
 Date Set: 1/89
 Recovered By _____
 Date Recovered _____
 Recovered By _____
 Date Recovered _____
 Recovered By _____
 Date Recovered _____

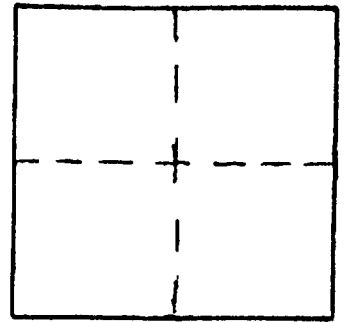

VERTICAL CONTROL

Elevation: _____ NGS Line # _____ USGS Line # _____ OSHD Line # _____
 Precision: _____ Agency: _____ Proj. # _____ Date: _____

HORIZONTAL CONTROL

South Zone State Plane Coordinates: Y(Northing) 601,161.50 X(Easting) 1,248,713.45
 Precision: 1/20,000 Agency: CITY(RSBG) Proj. # _____ Date: _____
 Approximate Geographic Position: Latitude 43°16'53" Longitude 123°19'19"


DESCRIPTION and TO REACH

Brass cap stamped "RSBG 62" set flush in concrete.

TO REACH:

Go to end of pavement on Newton Road, turn left through locked gate onto gravel road to top of ridge, staying to the right past metal barn. Stay on main road past rock pit, at first road past rock pit turn right to landing.

SKETCH

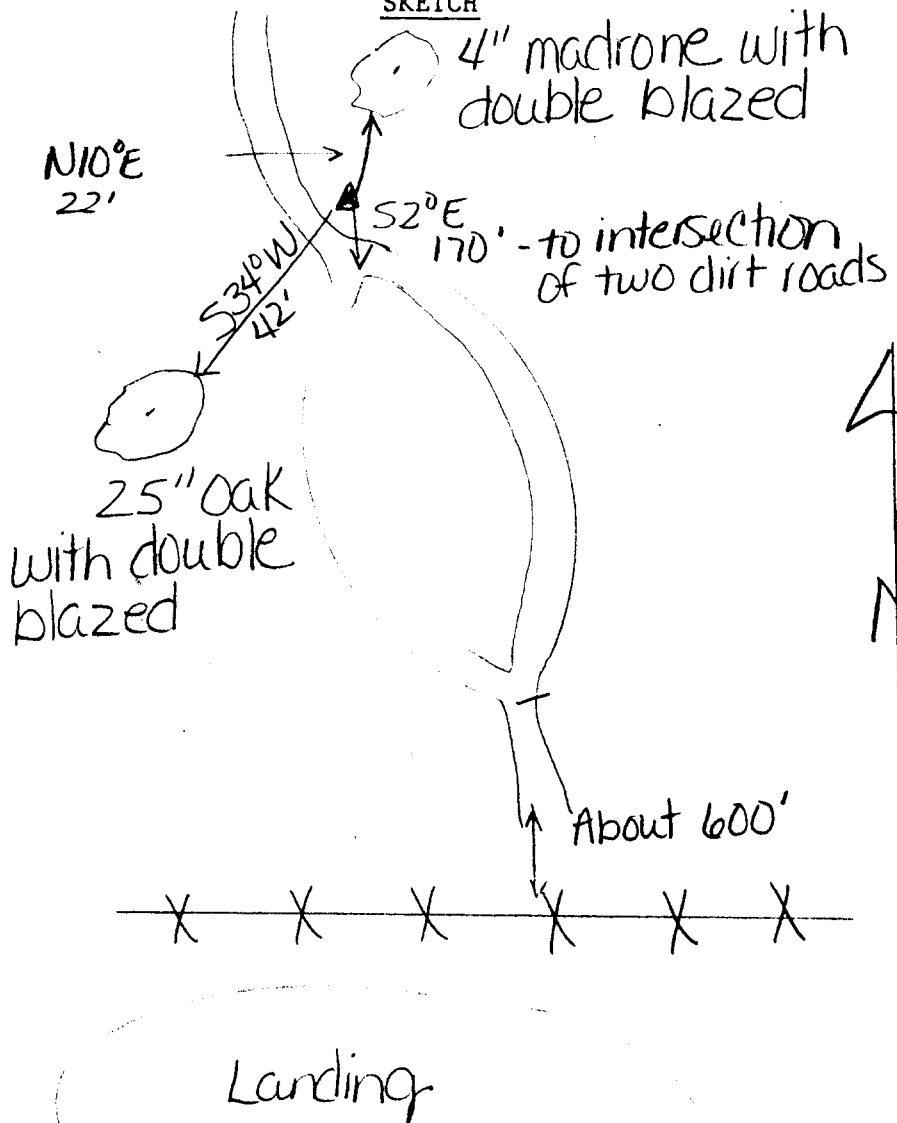

Reference Marks: