




Station: RSBG 61 T 26 S, R 5 W , Sec 31
 Set By (Agency): CITY(RSBG)
 Date Set: 1/89
 Recovered By _____
 Date Recovered _____
 Recovered By _____
 Date Recovered _____
 Recovered By _____
 Date Recovered _____

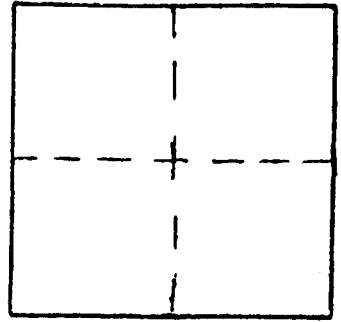

VERTICAL CONTROL

Elevation: 1536.0 NGS Line # _____ USGS Line # _____ OSHD Line # _____
 Precision: VA Agency: _____ Proj. # _____ Date: _____

HORIZONTAL CONTROL

South Zone State Plane Coordinates: Y(Northing) 597,069.89 X(Easting) 1,246,208.77
 Precision: 1/20,000 Agency: CITY(RSBG) Proj. # _____ Date: _____
 Approximate Geographic Position: Latitude 43°16'12" Longitude 123°19'51"


DESCRIPTION and TO REACH

Brass cap stamped "RSBG 61", on 2" x 30" steel pipe set in concrete, cap is 1.35 above ground level.

TO REACH:

Go to end of pavement on Newton Road, turn left through locked gate on to gravel road to top of ridge, stay to the right until metal barn, then left, then right on dirt road about 400 feet.

SKETCH

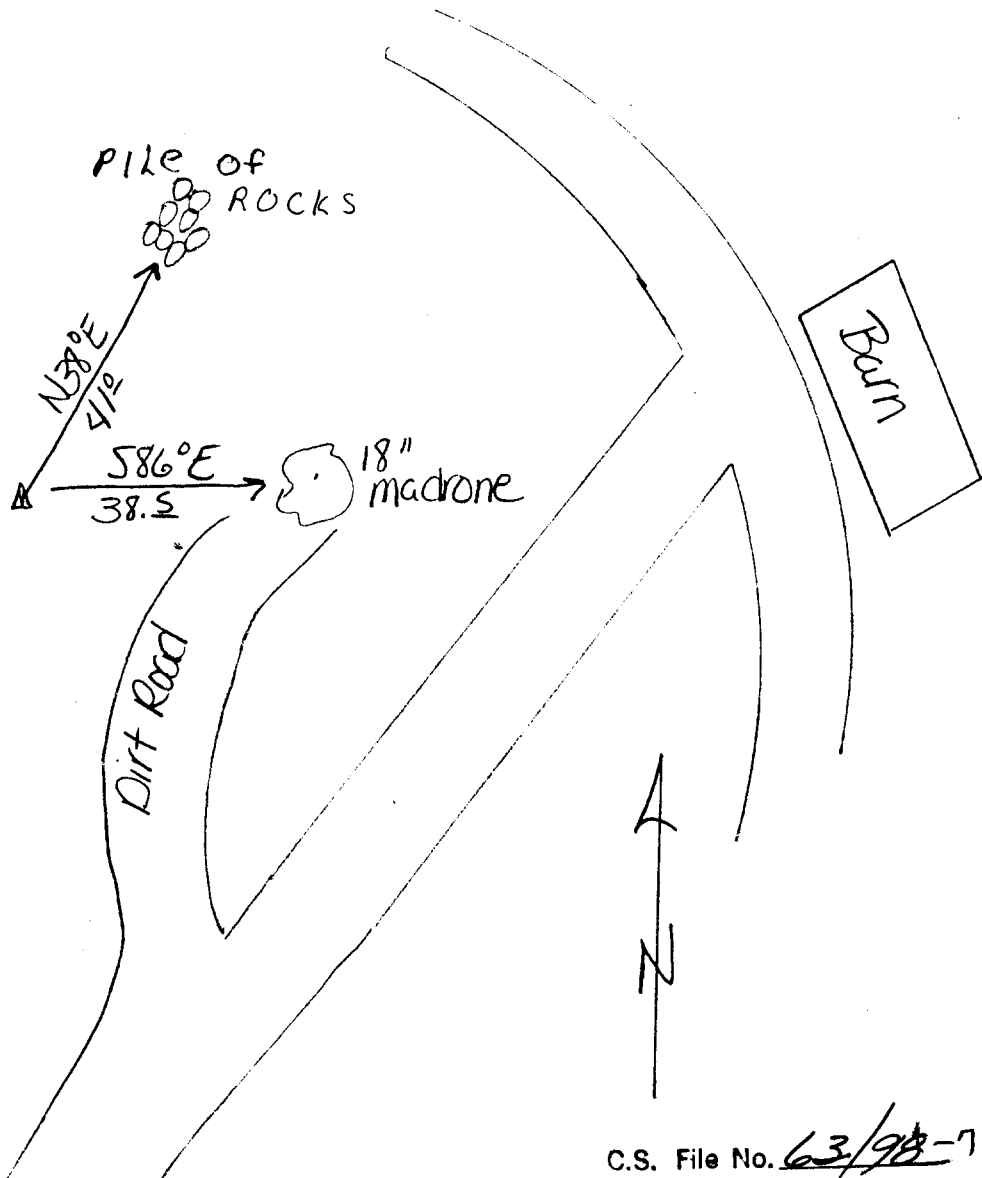

Reference Marks: