




Station: RSBG 10
Set By (Agency): CITY (RSBG)
Date Set: 1/89
Recovered By _____
Date Recovered _____
Recovered By _____
Date Recovered _____
Recovered By _____
Date Recovered _____

T 27 S, R 5W , Sec 6

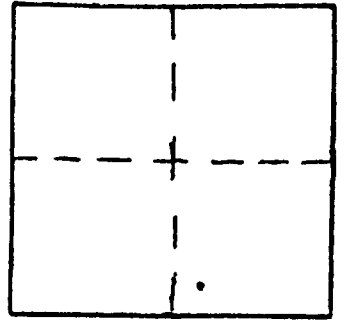

VERTICAL CONTROL

Elevation: 660.27 NGS Line # _____ USGS Line # _____ OSHD Line # _____
Precision: _____ Agency: _____ Proj. # _____ Date: _____

HORIZONTAL CONTROL

South Zone State Plane Coordinates: Y(Northing) 588,792.92 X(Easting) 1,245,947.56
Precision: 1/20,000 Agency: CITY (RSBG) Proj. # _____ Date: _____
Approximate Geographic Position: Latitude 43°14'50" Longitude 123°19'51"


DESCRIPTION and TO REACH

SKETCH

DCSO disk stamped "RSBG 10"
flush in concrete.

TO REACH:

Monument is 0.1 mile out
Newton Road from Newport
Drive and on top of cut
bank about 10 feet above
street level.

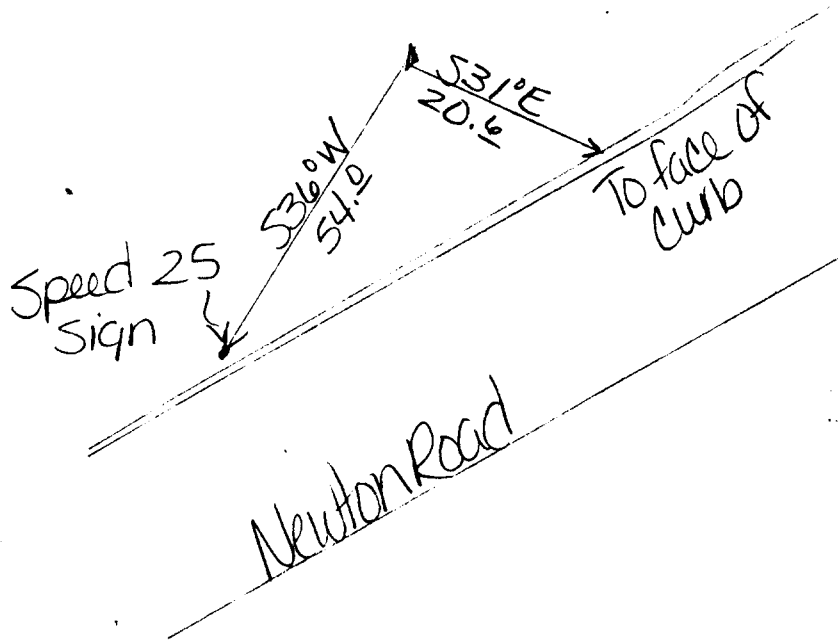

Reference Marks: