




Station: 53 RSBG 53 T 27 S, R 5 W , Sec 17
 Set By (Agency): CITY(RSBG)
 Date Set: 1/89
 Recovered By _____
 Date Recovered _____
 Recovered By _____
 Date Recovered _____
 Recovered By _____
 Date Recovered _____

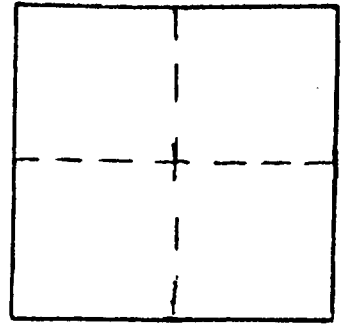

VERTICAL CONTROL

Elevation: 1126.2 NGS Line # _____ USGS Line # _____ OSHD Line # _____
 Precision: VA Agency: _____ Proj. # _____ Date: _____

HORIZONTAL CONTROL

South Zone State Plane Coordinates: Y(Northing) 581,550.71 X(Easting) 1,252,294.00
 Precision: 1/20,000 Agency: CITY(RSBG) Proj. # _____ Date: _____
 Approximate Geographic Position: Latitude 43°13'41" Longitude 123°18'22"


DESCRIPTION and TO REACH

Brass cap stamped "RSBG 53"
 set flush in concrete.

TO REACH:

Go up Frontier Lane past
 water tower to top of ridge
 follow underground phone line
 North along ridge top until
 it turns 90° East off the ridge,
 continue North along top of
 ridge trail about 650 feet.

SKETCH

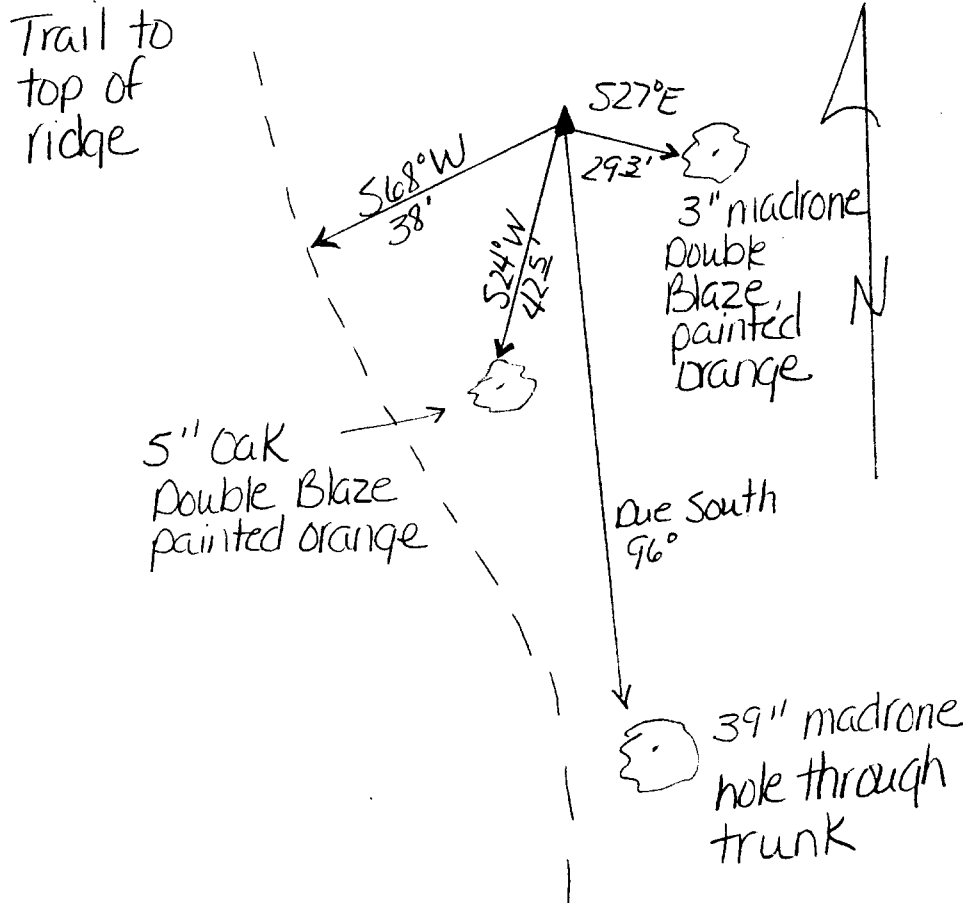

Reference Marks: