




Station: RSBG 51 T 27 S, R 6 W, Sec 25  
Set By (Agency): CITY (RSBG)  
Date Set: 1/89  
Recovered By \_\_\_\_\_  
Date Recovered \_\_\_\_\_  
Recovered By \_\_\_\_\_  
Date Recovered \_\_\_\_\_  
Recovered By \_\_\_\_\_  
Date Recovered \_\_\_\_\_  
Recovered By \_\_\_\_\_  
Date Recovered \_\_\_\_\_

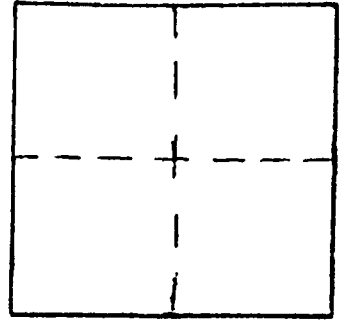

VERTICAL CONTROL

Elevation: 737.6 NGS Line # \_\_\_\_\_ USGS Line # \_\_\_\_\_ OSHD Line # \_\_\_\_\_  
Precision: \_\_\_\_\_ Agency: \_\_\_\_\_ Proj. # \_\_\_\_\_ Date: \_\_\_\_\_

HORIZONTAL CONTROL

South Zone State Plane Coordinates: Y(Northing) 569,037.70 X(Easting) 1,242,235.95  
Precision: 1/20,000 Agency: CITY (RSBG) Proj. # \_\_\_\_\_ Date: \_\_\_\_\_  
Approximate Geographic Position: Latitude 43°11'34" Longitude 123°20'32"


DESCRIPTION and TO REACH

SKETCH

Brass cap stamped  
"RSBG 51" set flush  
in concrete.

TO REACH:

Go East on Booth Street  
to 2004 address then  
Northwest about 400' towards  
big oak tree.

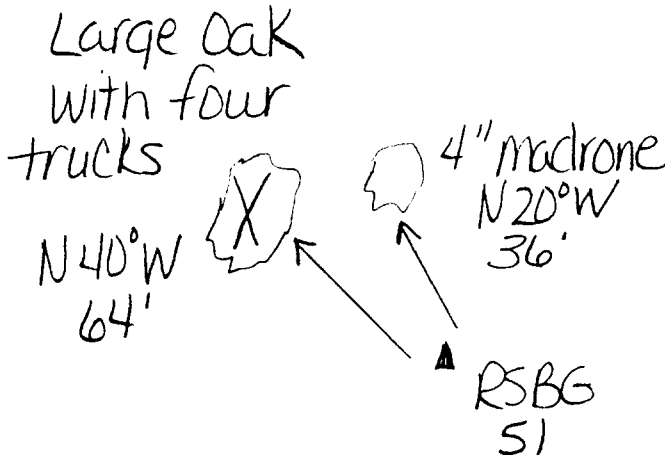

2004

Reference Marks:

Booth Street