




Station: RSBG 50 T 27 S, R 6 W, Sec 26
 Set By (Agency): CITY (RSBG)
 Date Set: 1/89
 Recovered By _____
 Date Recovered _____
 Recovered By _____
 Date Recovered _____
 Recovered By _____
 Date Recovered _____

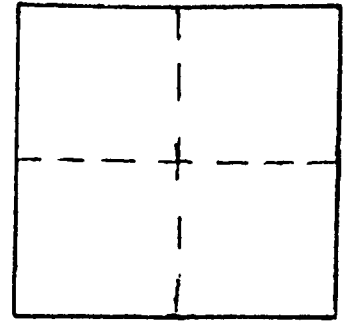

VERTICAL CONTROL

Elevation: 466.18 NGS Line # _____ USGS Line # _____ OSHD Line # _____
 Precision: _____ Agency: _____ Proj. # _____ Date: _____

HORIZONTAL CONTROL


South Zone State Plane Coordinates: Y(Northing) 567,702.76 X(Easting) 1,235,003.22
 Precision: 1/20,000 Agency: CITY (RSBG) Proj. # _____ Date: _____
 Approximate Geographic Position: Latitude 43°11'18" Longitude 123°22'09"

DESCRIPTION and TO REACH

SKETCH

FROM EXIT #123 ON I-5 (FAIRGROUNDS) PROCEED SOUTH 0.9 MILE. ALUMINUM DISK IS ONE FOOT FROM ROAD EDGE.

Alum. disk on 5/8" rebar
 stamped "RSBG 50"
 set flush in edge of asphalt.

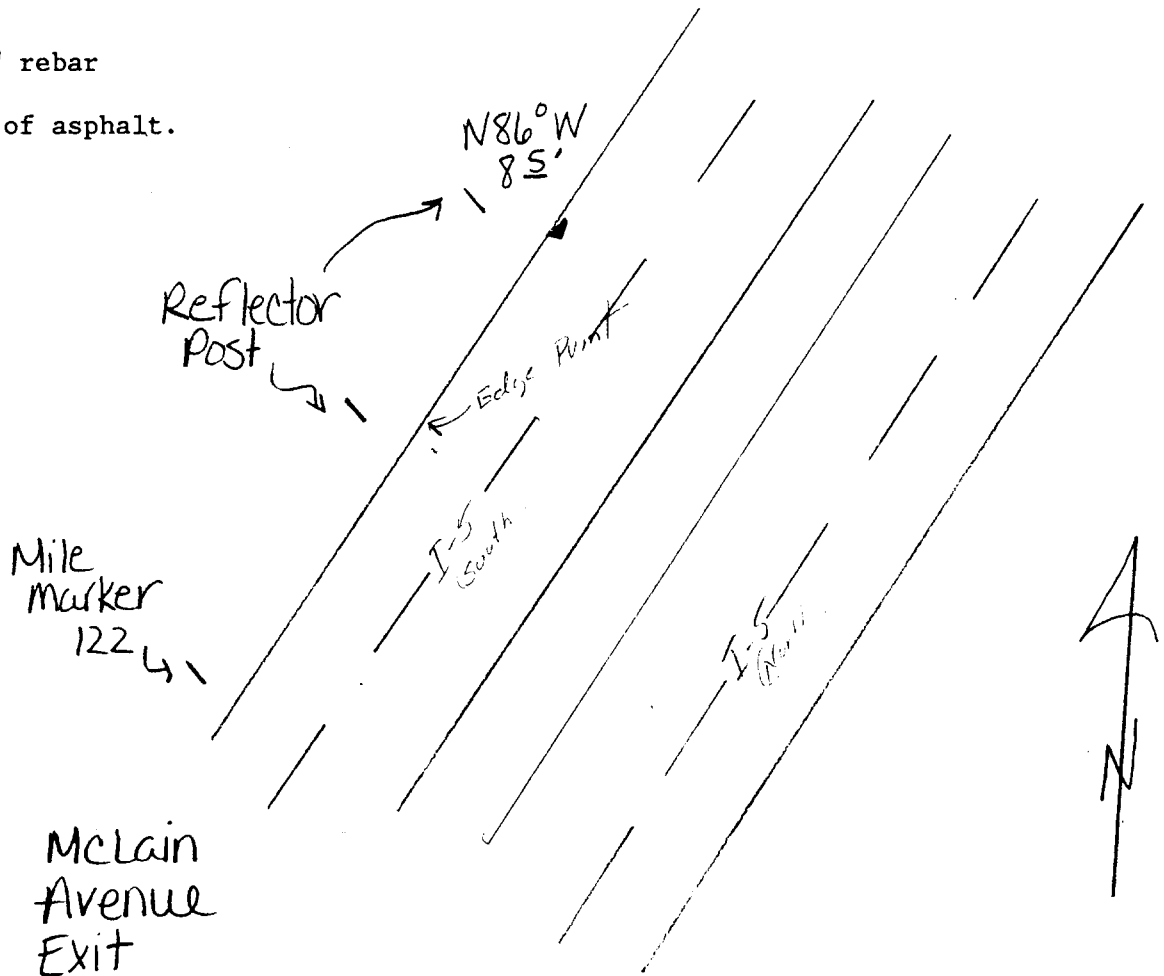

Reference Marks:

Mclain
 Avenue
 Exit