

Closing corner sections 24 & 25,
T23S, R9W, WM

DATE: 12-28-89

FILED

JK
JAN 12 1990

- Condition Report Only
- Not Found
- Renewed
- Unrecorded
- Surveyed In
- Referenced Out


COUNTY SURVEYOR
DOUGLAS COUNTY, ORE

Reed

Previous Renewal #'s 26 & 91 T23-9 T23-8
#679/29

Monument(s) Found: (Condition and Source) Found 1" iron post
with 2 1/2" brass cap marked:

The monument was tipped down
hill (SE) ± 2 feet and under debris
from logging operation.

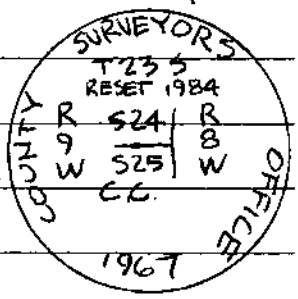

Accessories Found: (Condition and Source) Found

± 70" D. fir, 36.0, bark scribing visible
13" Hemlock, 17.7, two small faces, not yet
healed scribing visible
~ ?" maple in group of 3 or 4 has broken off
at ground level - no attempt made to measure
± 30" W.R. Cedar, now a snag 25' tall, it has

#98 T23-94
#132 T23-84

slipped down the hill ± 20 feet (it is still upright but leaning to SW), it will probably slide farther down the hill and wipe out the monument sometime in the future. No measure taken.

RENEWAL


Monument Set: (Procedure and Description) We reset the county monument upright, the bottom had not moved. No attempt was made to find the chiseled '+' in bedrock (renew #91).

New Accessories: (Description) None

I set 6' steel post with USFS Attention sign 1.2 feet west of monument.

The corner is on a very steep ($\pm 85\%$) SE slope. It is $\pm 70'$ from creek bottom and on the edge of a recent BLM clearcut, (unit #2 old Camp Timber Sale).

Location and Comments:

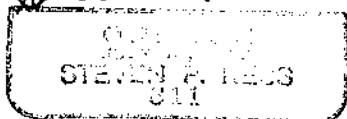

Leavitt, Ness & Co.

S.R. Ness

"

K.R. Leavitt

Compass Declination

Agency

Party Chief

Notekeeper

Witnesses