

FILED

JAN 12 1990

OREGON CORNER RESTORATION FORM

Section 35 Township 30S Range 9W

County Douglas Date 1/3/90

COUNTY SURVEYOR  
DOUGLAS COUNTY, ORE.

Corner Designation

- Condition Report Only
- Not Found
- Renewed
- Unrecorded
- Surveyed In
- Referenced Out

Previous Renewals/Surveys, etc.


See Map - M 79-18

Monument(s) & Accessories Found: (Condition and Source)

5/8" X 24" iron rod with Aluminum Cap  
30" D.F. South 12<sup>2</sup> Marked "W 1/16 BT"  
16" Madrone N 20<sup>E</sup> 28<sup>7</sup> - Now a Stamp

Monument Detail

Sketch

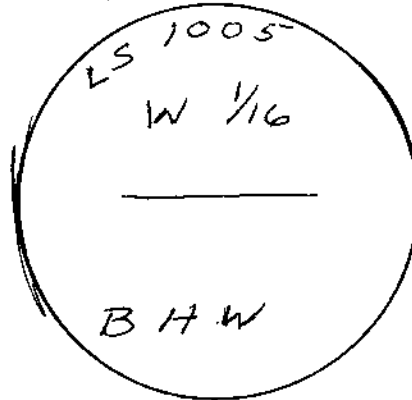

Monument Set (Procedures and Description)

\_\_\_\_\_  
 \_\_\_\_\_  
 \_\_\_\_\_

New Accessories

10" D.F. West 37<sup>7</sup> ft. Scribed "W 1/16 BT"

Location & Comments

Corner is in the  
SE corner of a  
recent clear cut  
Unit.

Compass Declination 20°

Firm/Agency \_\_\_\_\_

Roseburg Forest Products

Address P.O. Box 1088

Roseburg, OR 97470

Party Chief HW Johnstone

Notes Bill Olson

Witness \_\_\_\_\_

Surveyor's Seal

REGISTERED  
 PROFESSIONAL  
 LAND SURVEYOR

Howard W. Johnstone

OREGON  
 MAY 13, 1960  
 HOWARD W. JOHNSTONE  
 498

C.S. File No. 63/104-3