

FILED *JL*

OREGON CORNER RESTORATION FORM

JAN 25 1990

Section 31 Township 29S Range 6W

COUNTY SURVEYOR  
DOUGLAS COUNTY, ORE.

County Douglas Date 1/23/90

Corner Designation

South East Section Corner.

- Condition Report Only
- Not Found
- Renewed
- Unrecorded
- Surveyed In
- Referenced Out

True Closing Corner.

Previous Renewals/Surveys, etc.

set 1980 Cad Resurvey

*Vol. 45  
B. 17259-60*

Monument(s) & Accessories Found: (Condition and Source)

I.P. with Brass Cap.


6" Fir N72<sup>3</sup>/<sub>4</sub> W 58<sup>4</sup> High Stumped gone 1980 CAD

8" Fir N64<sup>1</sup>/<sub>2</sub> E 35<sup>6</sup> good face - High stumped, 1980 CAD

23<sup>1</sup>/<sub>2</sub> ft. North to AM-CC Brass CAP. 1958 CAD

Monument Detail

Sketch

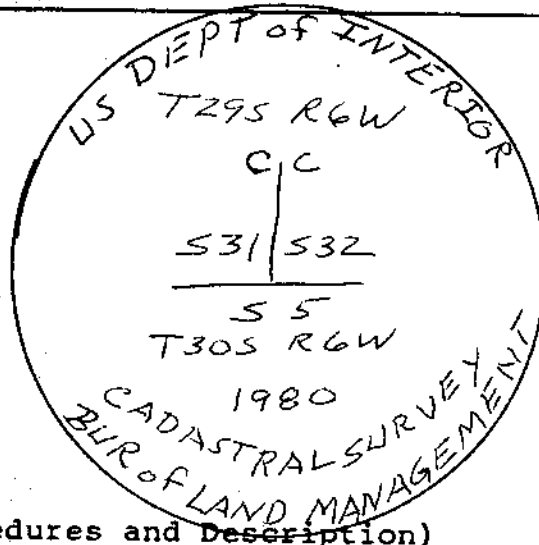

Monument Set (Procedures and Description)

New Accessories

Tied Cor to remaining Bt's for the AM-CC

50" DF Stamp bark scribed - N36W 67°

18" Fir healed face - N37<sup>1</sup>/<sub>2</sub> E 45<sup>5</sup>

25" W Fir " " N54E 49<sup>6</sup>

Location & Comments

Surveyor's Seal

Corner lays in NE Cor Compass Declination 20°

of 1989-90 clear cut Firm/Agency Roseburg

unit logging all around Forest Products

The corner, About Address P.O. Box 1088

200 ft. South of Roseburg, OR 97470

road. Party Chief HW Johnstone

Notes \_\_\_\_\_

Witness \_\_\_\_\_

REGISTERED  
PROFESSIONAL  
LAND SURVEYOR

*Howard W. Johnstone*

OREGON  
MAY 13, 1960  
HOWARD W. JOHNSTONE  
498

*#262 ✓*

C.S. File No. 63/104-4

*C*