

FILED

jh

JAN 25 1990

OREGON CORNER RESTORATION FORM

Section 31 Township 29S Range 6W

County Douglas Date 1/23/90

COUNTY SURVEYOR
DOUGLAS COUNTY, ORE.

Corner Designation

South East Section Corner.
AM - CC

- Condition Report Only
- Not Found
- Renewed
- Unrecorded
- Surveyed In
- Referenced Out


Previous Renewals/Surveys, etc. 119, 225
1958 and 1980 Cad. Surveys.

Monument(s) & Accessories Found: (Condition and Source)

- Brass Cap and Iron Pipe
- 50" Fir N53 1/2 W 57 E Now a Stump Bark Scribed. 1959 CAD
- 18" Fir N61 1/2 E 29 Z Scar good Condition OBT
- 23" Yew N51 1/2 E 44 G Down from logging 1956 Markham
- 25" Grand Fir N79 E 40 Z Closed face good condition 1958 CAD
- 18" I.Ced. S5 1/2 W 31 Z Down and cut 1956 - Markham
- 23 ft. South to true CC Brass Cap. 1980 CAD

Monument Detail

Sketch

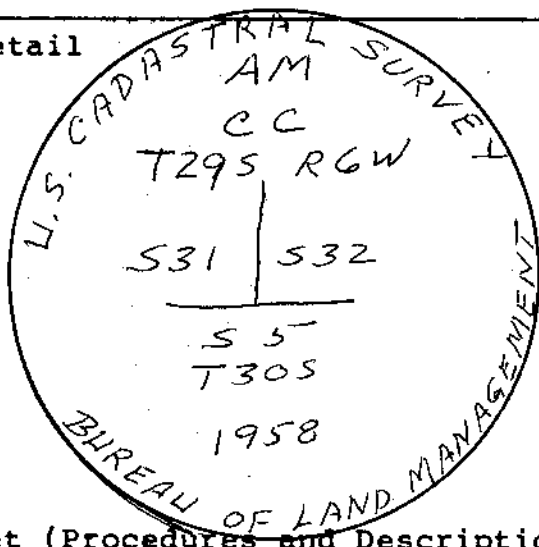

Monument Set (Procedures and Description)

New Accessories

Location & Comments

Surveyor's Seal

Cor. lays in NE Corner of 1989-90 Clear Cut logging all around the Corner. About 200 ft South of a road.

Compass Declination 20°

Firm/Agency Roseburg Forest Products

Address P.O. Box 108B Roseburg, OR

Party Chief HW Johnstone

REGISTERED
PROFESSIONAL
LAND SURVEYOR

Howard W. Johnstone

Notes _____

Witness _____

OREGON
MAY 13, 1960
HOWARD W. JOHNSTONE
498

1980 AM CC
V. 45 P. 17259

Vol. 30 V. 42
P. 12813 P. 16526
1958 1980

Ren #119