

FILED

JR
JAN 25 1990

OREGON CORNER RESTORATION FORM

Section 5 Township 30S Range 6W

County Douglas Date 1/23/90

COUNTY SURVEYOR
DOUGLAS COUNTY, ORE.

Corner Designation

N.W. Section Cor of Sec. 5
Closing Corner.

- Condition Report Only
- Not Found
- Renewed
- Unrecorded
- Surveyed In
- Referenced Out

Previous Renewals/Surveys, etc.

1958 Cad Resurvey D.C. No 132-T30-6

Monument(s) & Accessories Found: (Condition and Source)

I.P. with Brass Cap.

48" Fir N53W 72ft Low Stamp. "No Record" 19

18 Fir S43 3/4 E 67 3/4 Snag down 1958 CAD


12 G. Fir S78 1/2 E 37 1/2 High Stamp. + Pushed over. 1980 CAD

28 Fir S23W 62 1/2 High Stamp Healed Face 1958 CAD

34 Fir S43 1/4 W 19 1/2 Wind Fall, Scar visible, logs cut 1905 CAD

1950
V. #2 Pg. 16566
1980
V. #30 Pg. 12813-14
1985
Pg. 17254

Monument Detail

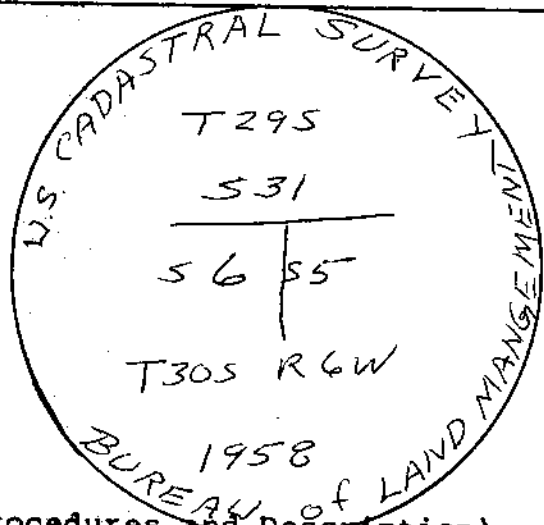

Sketch

Monument Set (Procedures and Description)

New Accessories

16" W. Fir N61W 65° Scribed "T295 R6W 531 BT"

7 D.I. Fir S70W 56 3/4 Scribed T30S R6W 56 BT

Location & Comments

Cor lays in N.W. Cor

of 1984-90 Clear Cut

unit about 100' South

of road.

Compass Declination 20°

Firm/Agency Roseburg

Forest Products.

Address P.O. Box 1089

Roseburg, OR 97470

Party Chief H.W. Johnstone

Notes _____

Witness _____

Surveyor's Seal

REGISTERED
PROFESSIONAL
LAND SURVEYOR

HOWARD W. JOHNSTONE

OREGON
MAY 13, 1960
HOWARD W. JOHNSTONE
498

#296 T30-6 4

C.S. File No. 63/104-6

C