


CERTIFIED RECORD OF LAND CORNER MONUMENTATION

History of original corner establishment:

Original corner stone not found by Powell in 1969, original bearing trees found, set 1" iron pipe with 2 1/2" brass cap. 1" iron pipe with 2 1/2" brass cap set by DCSD in 1969, found by Quimby & Ware in 1980. I found a 1" iron pipe with a 2 1/2" brass cap 18" above the ground, in a 20" dia. rock mound.

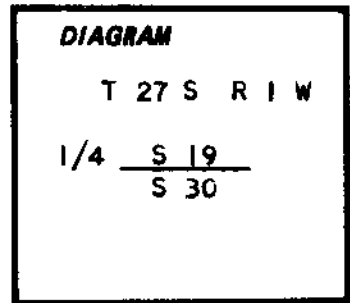

Description of corner evidence found:

16" Cedar (stump) now down (record) S 5° E, 12.5 feet. *1012*
30" Cedar (snag) bears N 20° E, 49.0 feet, scribing visible. (record N 17° E) # *1013*
42" D. Fir (stump) bears S 32° E, 56.0 feet, scribing visible. *1013*
16" Cedar (stump) bears S 32° W, 41.6 feet, scribing visible. (record S 30° E) *Ren #155-*

Description of monument and accessories I established to perpetuate the original location of this corner:

4" D. Fir bears N 16° 30' E, 55.4 feet, I scribed "1/4 S19 BT" alum. tag marked "ARTMAN RLS 2268" nailed flush to BT face.
4" D. Fir bears S 88° W, 60.8 feet, I scribed "1/4 S30 BT" alum. tag marked "ARTMAN RLS 2268" nailed flush to BT face.

Painted and tagged all BTs.
Enlarged rock mound to 36" dia.

REGISTERED
PROFESSIONAL
LAND SURVEYOR

J D Artman
OREGON
JULY 16, 1987
JAMES D. ARTMAN
2268

FILED

JL
MAY 29 1990

COUNTY SURVEYOR
DOUGLAS COUNTY, ORE.

Office of.....SURVEYOR..... County of.....Douglas.....
State of.....Oregon....., I hereby certify that the within instrument was filed in this office
for record on the.....29..... day of.....May....., 19.90
Fritz Ingram..... by *Virginia C. Saenger*
(COUNTY OFFICIAL) (DEPUTY)

#199 +