


CERTIFIED RECORD OF LAND CORNER MONUMENTATION

History of original corner establishment:

Shrum found original corner stone with original bearing trees, in 1961.
County Surveyors Office found original corner stone and original bearing tree stumps, in 1969.
R. Quimby found 1" iron pipe set by county surveyors office and original bearing trees and trees marked by county surveyors office, in 1980.

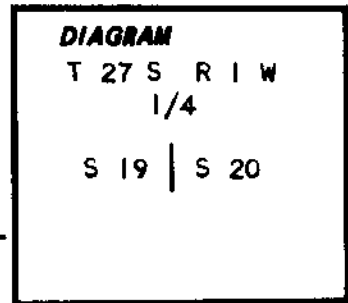

Description of corner evidence found:

Found 1" iron pipe with 2 1/2" brass cap 16" above ground.

48" D. Fir (stump) bears S 48° E, 17.8 feet, scribing visible.
(record Shrum 1961 S 48° E, 17.8 feet)
(record DCSO 1969 S 48° E, 17.8 feet)
(record Quimby 1980 S 48° E, 18.2 feet)

48" D. Fir (stump) bears N 32° W, 15.2 feet, scribing visible.
(record Shrum 1961 N 32° W, 15.2 feet)
(record DCSO 1969 N 32° W, 15.2 feet)
(record Quimby 1980 N 36° W, 14.8 feet)

18" Hemlock bears S 39° W, 55.7 feet, healed blaze.
(record Shrum 1961 S 41° W, 55.7 feet)
(record DCSO 1969 S 39° W, 55.7 feet)

Description of monument and accessories established to perpetuate the original location of this corner:

(continued below)

(record Quimby 1980 S 39° W, 55.7 feet)

15" Hemlock bears S 34° E, 51.5 feet, healed blaze.

FILED

MAY 29 1990

COUNTY SURVEYOR
DOUGLAS COUNTY, ORE.

REGISTERED
PROFESSIONAL
LAND SURVEYOR

OREGON
JULY 16, 1987
JAMES D. ARTMAN
2268

Office of... SURVEYOR..... County of.. Douglas.....
State of.. Oregon.....

I hereby certify that the within instrument was filed in this office
for record on the 29... day of... May..... 19.. 90

Fritz Ingram..... by *Virginia A. Sargent*
(COUNTY OFFICIAL) (DEPUTY)